



Quincy

Ave

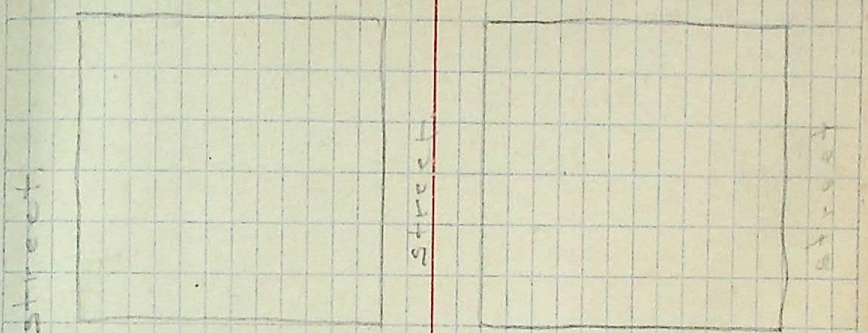



Monroe

Ave

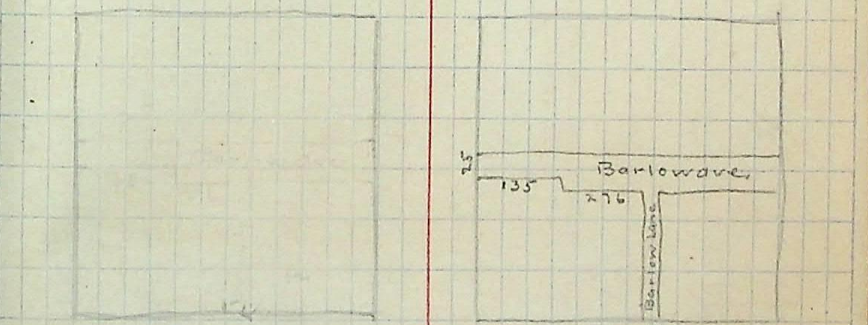

Madison

Ave

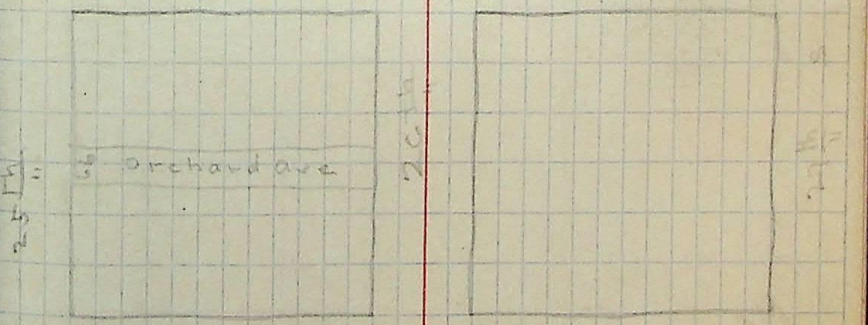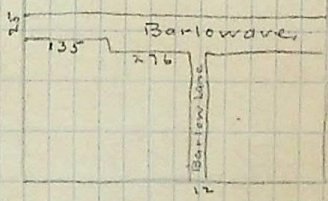

Jefferson

Ave

Orchard Ave