
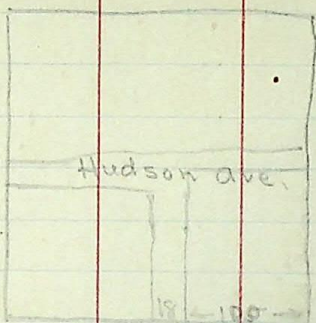


Washington



Ave.

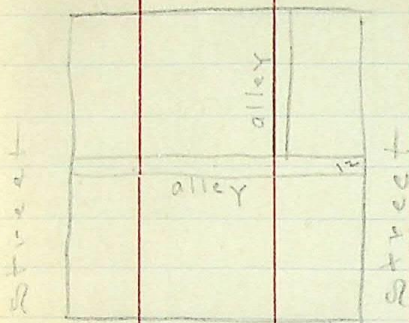

100 ft



Grant Ave

Ave.

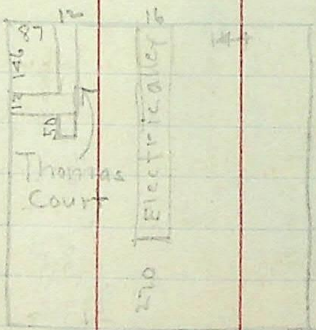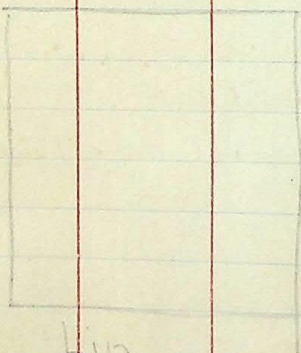

Lin.

Ave

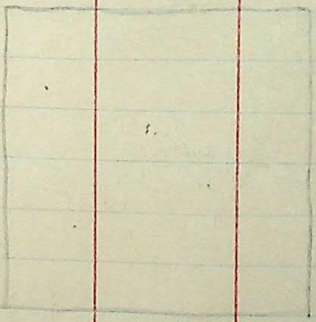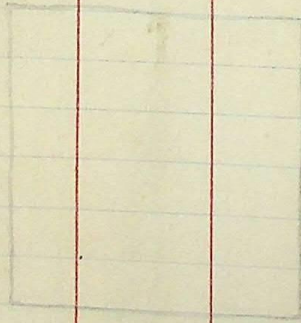

20 ft

24 ft

25 ft

Wall

Ave