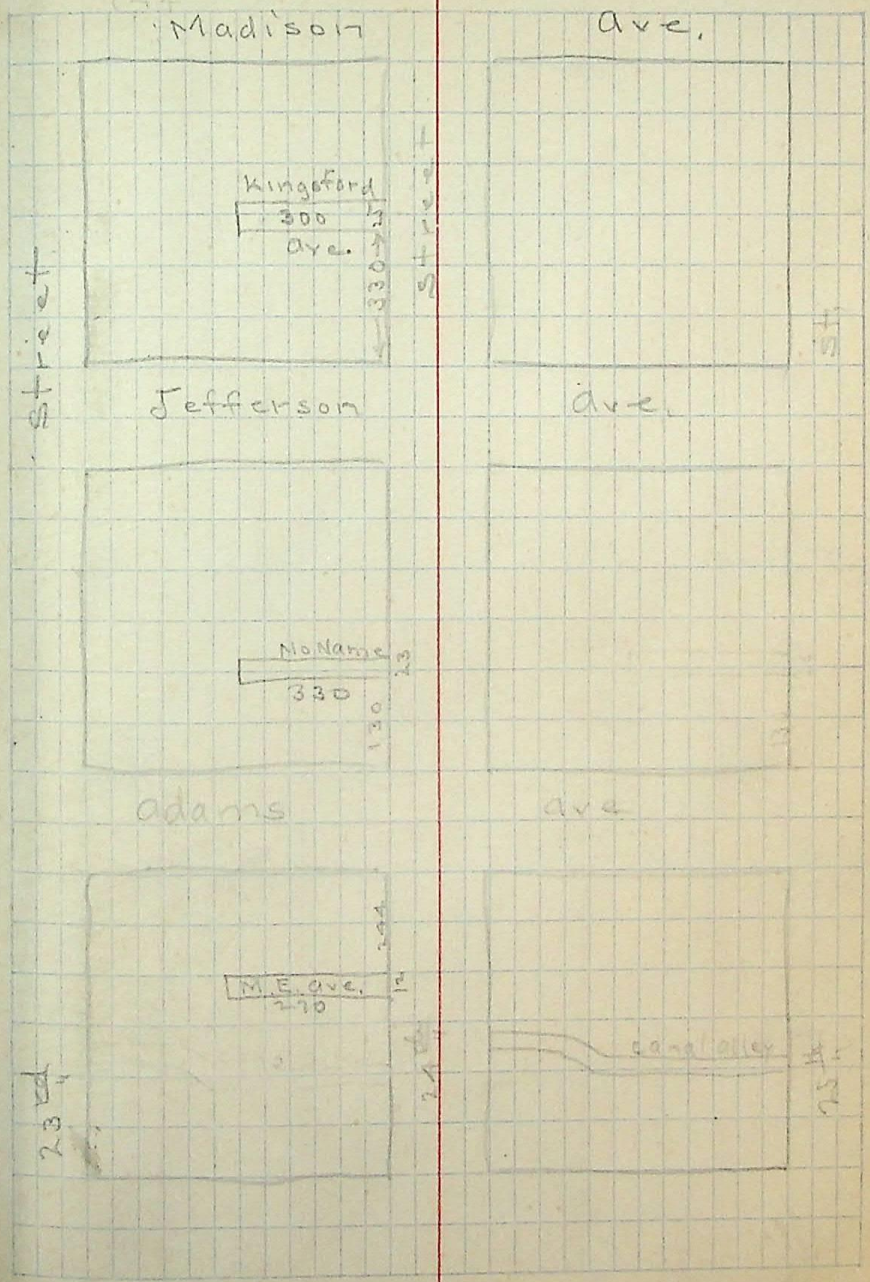
Madison
ave.
Kingsford
300
ave.
330
street
Jefferson
ave.
No Name
330
130
adams
ave
M.E. ave.
270
canal valley