



Washington

Ave.

Street



Street

Street

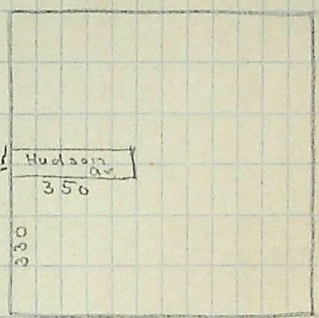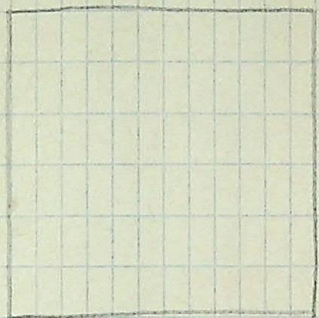



Grant

Ave.

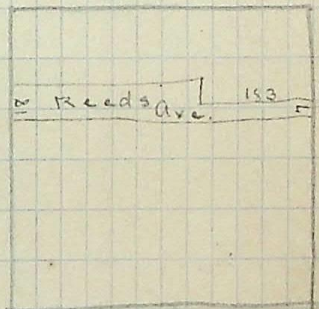 

Lincoln

Ave.

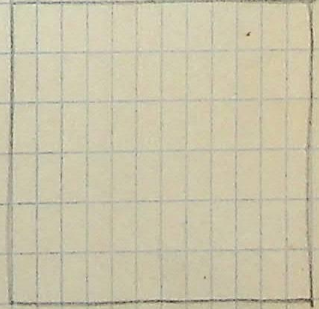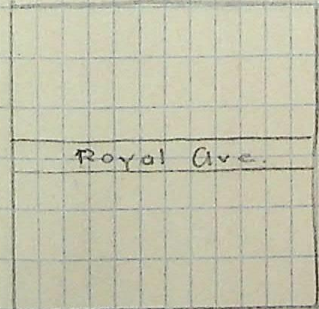

Royal Ave.

Wall

Ave.

21st

22nd

23rd