



19

Madison

100 ft


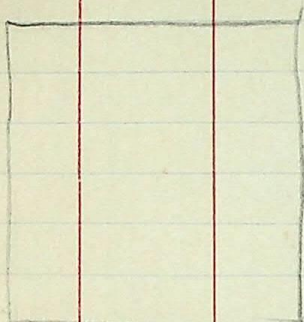


100 ft

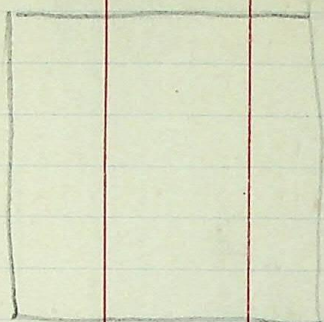

Jefferson


Ave

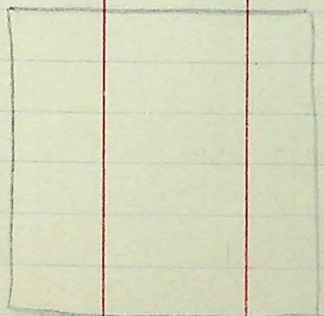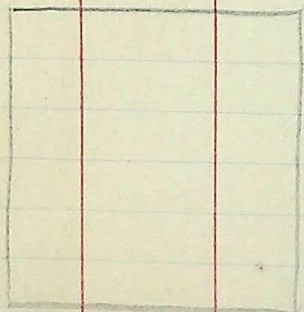


Adams

Ave

21 ft

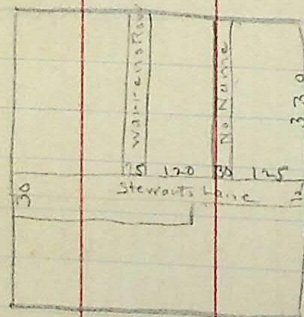

22 ft

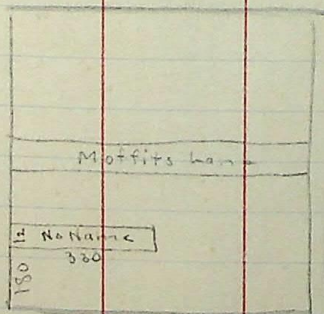

100 ft

23 ft

Washington

Ave