



Washington

Ave.

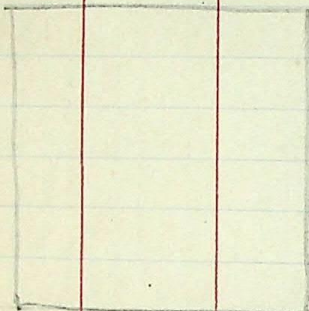


Street

Grant

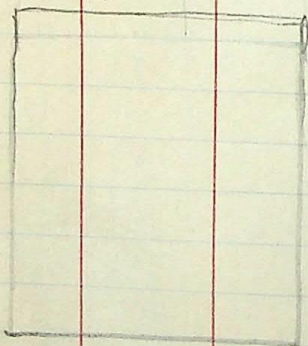


Lin.

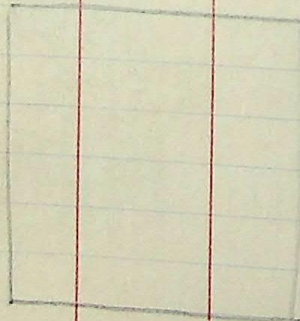





20th

Wall

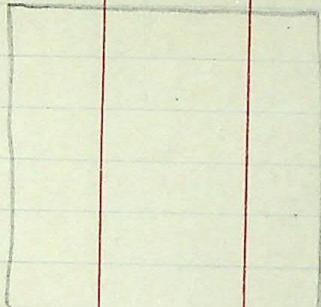

20th

Ave.

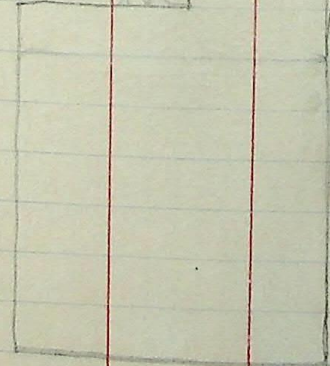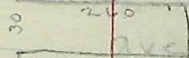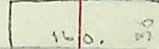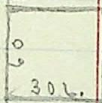

21st

ave.