



22710

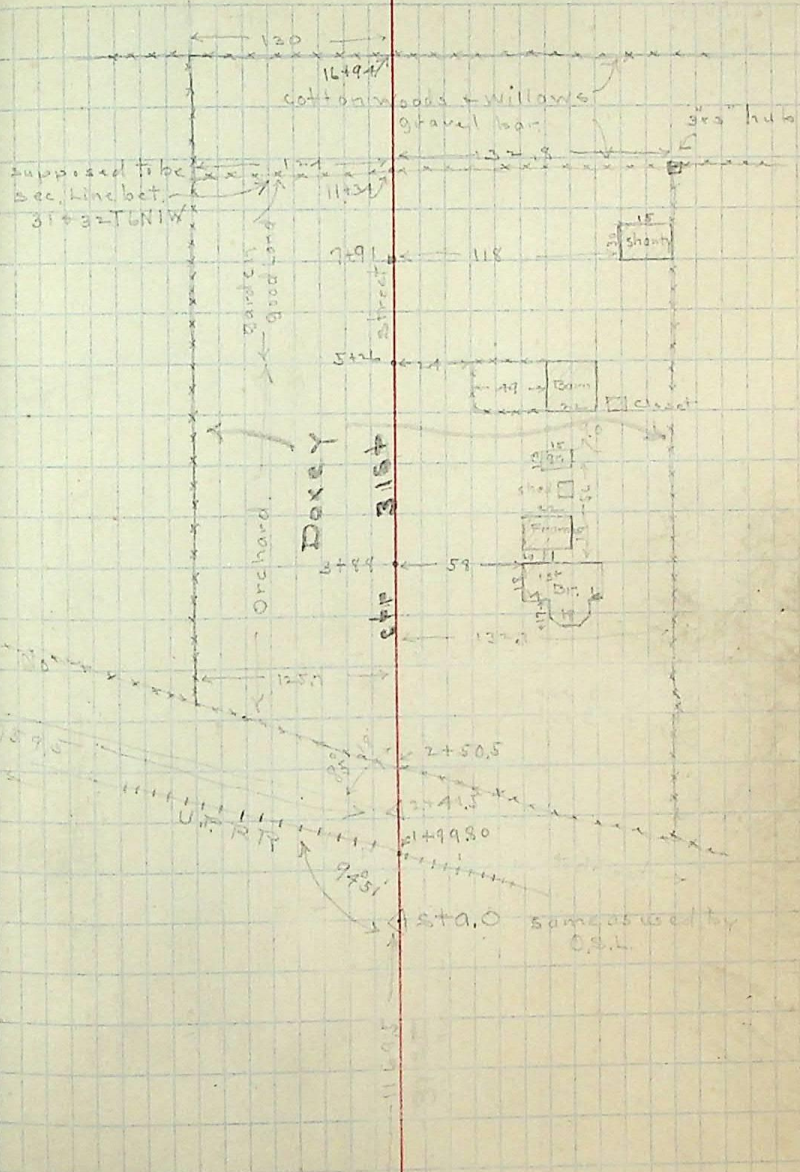

Hub at Inter. Walls 31 ft.

Wall

ave