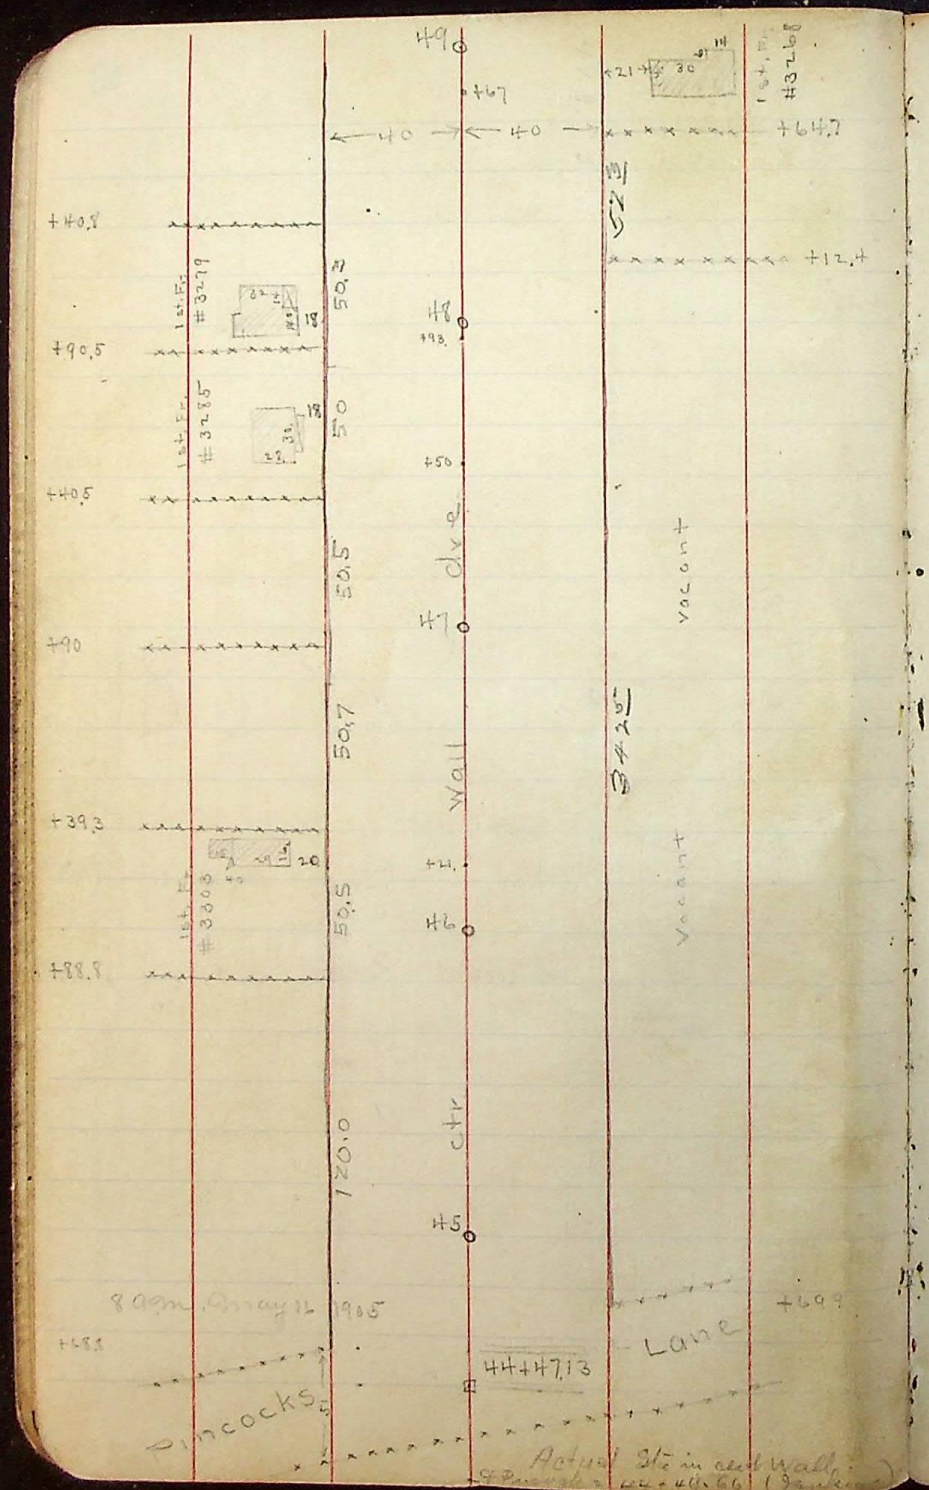
+49
+67
+21
30
1st. Fr.
#3268
+64.7
40
40
+40.8
1st. Fr.
#3279
50.2
+90.5
1st. Fr.
#3285
50
+40.5
50.5
+90
50.7
+39.3
1st. Fr.
#3303
20
50.5
+88.8
120.0
+8
+48
+50
+7
+4
+6
+5
Wall
Ctr
Vacant
Vacant
B425
+12.4
+69
Lane
8 a.m. May 12 1905
+68.1
Pincocks
44+47.13
Actual Sta in end wall
Pencil = 44.66 (Dunkin)

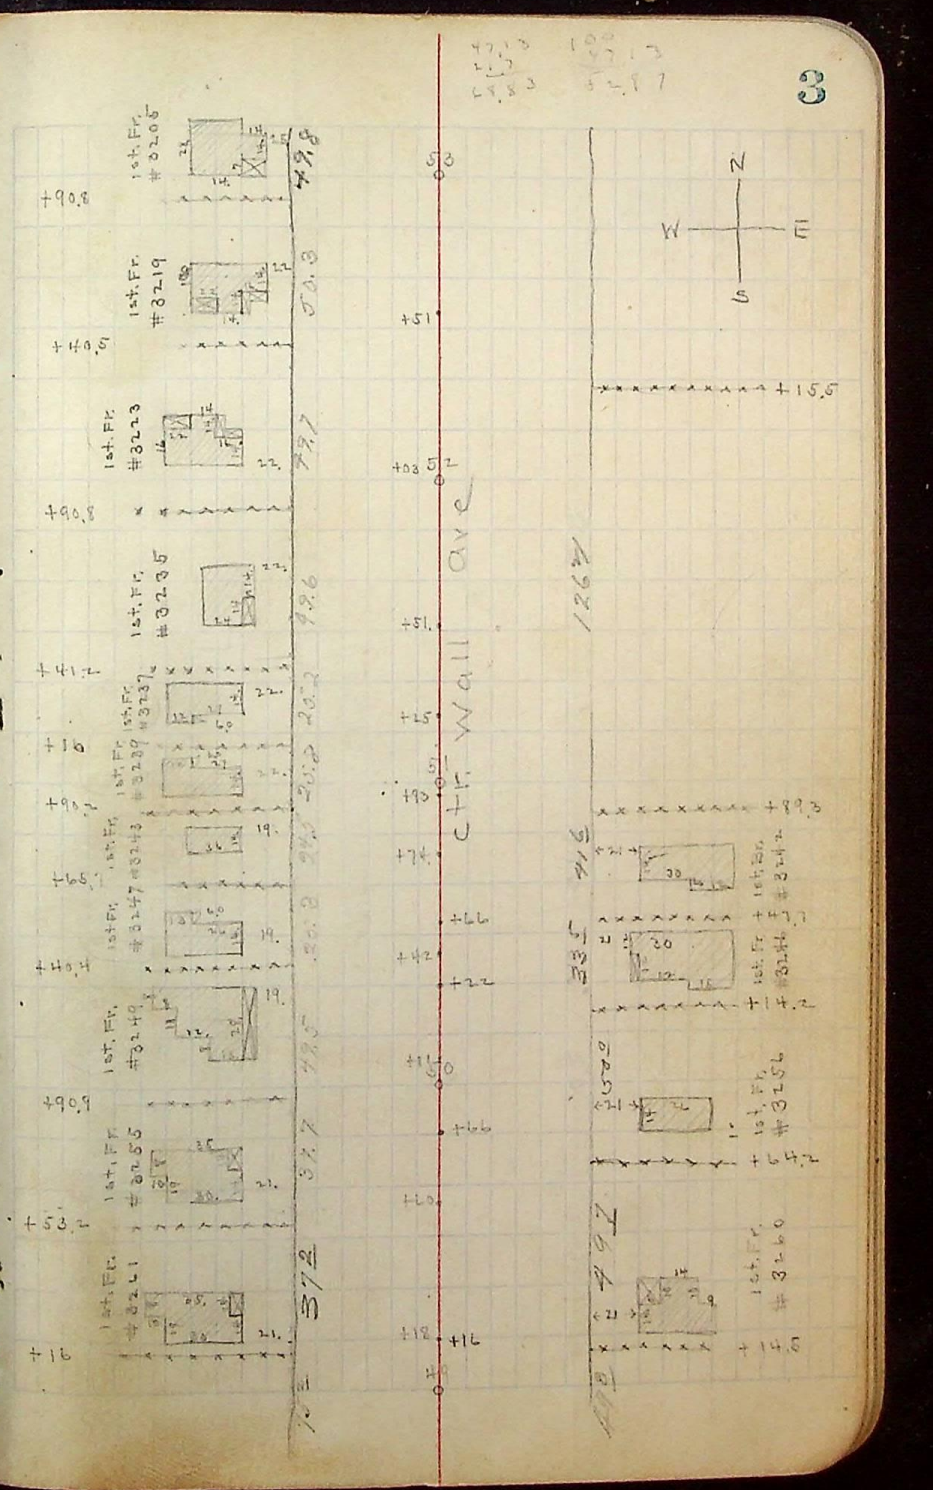
+90.8
1st. Fr.
#3206
79.8
+40.5
1st. Fr.
#3219
80.3
1st. Fr.
#3223
79.7
+90.8
1st. Fr.
#3235
79.6
+41.2
1st. Fr.
#3237
+16
1st. Fr.
#3239
80.2
+90.2
1st. Fr.
#3243
+65.1
1st. Fr.
#3247
+40.4
1st. Fr.
#3249
+90.9
1st. Fr.
#3255
+53.2
1st. Fr.
#3261
+16
3712
+58
+51
+03.5
+51.
+25
+90
+74
+66
+42
+22
+50
+66
+60
+12
+16
Ctr. Wall
Ave
+15.5
+89.3
1st. Fr.
#3274
+47.1
1st. Fr.
#3274
+14.2
1st. Fr.
#3256
+64.2
1st. Fr.
#3260
+14.5
N
W
E
S