


1st Flr #3158
1st Flr #3149

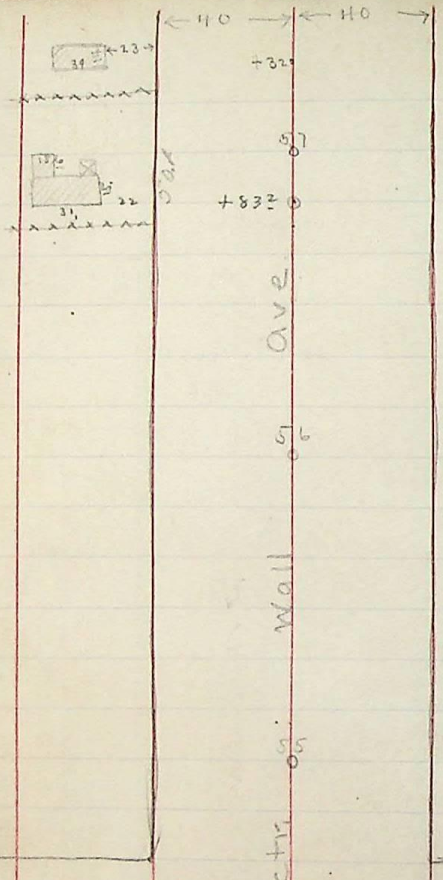

+36.95

32


+35.85

street

+37.00

+39.1

1st Flr #3203

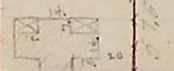

+39


+40.6

40.8

+39

179.2

1st Flr #3204

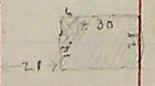

+39.5

+94.93


31.84

+94.85

Street

+55

40 40

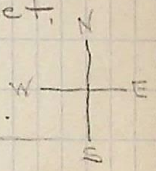

vacant

32.56


Wall St

vacant

vacant

+29.4

1st Flr #3145

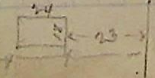

+29.4

+80.2

Chr

31

100.1