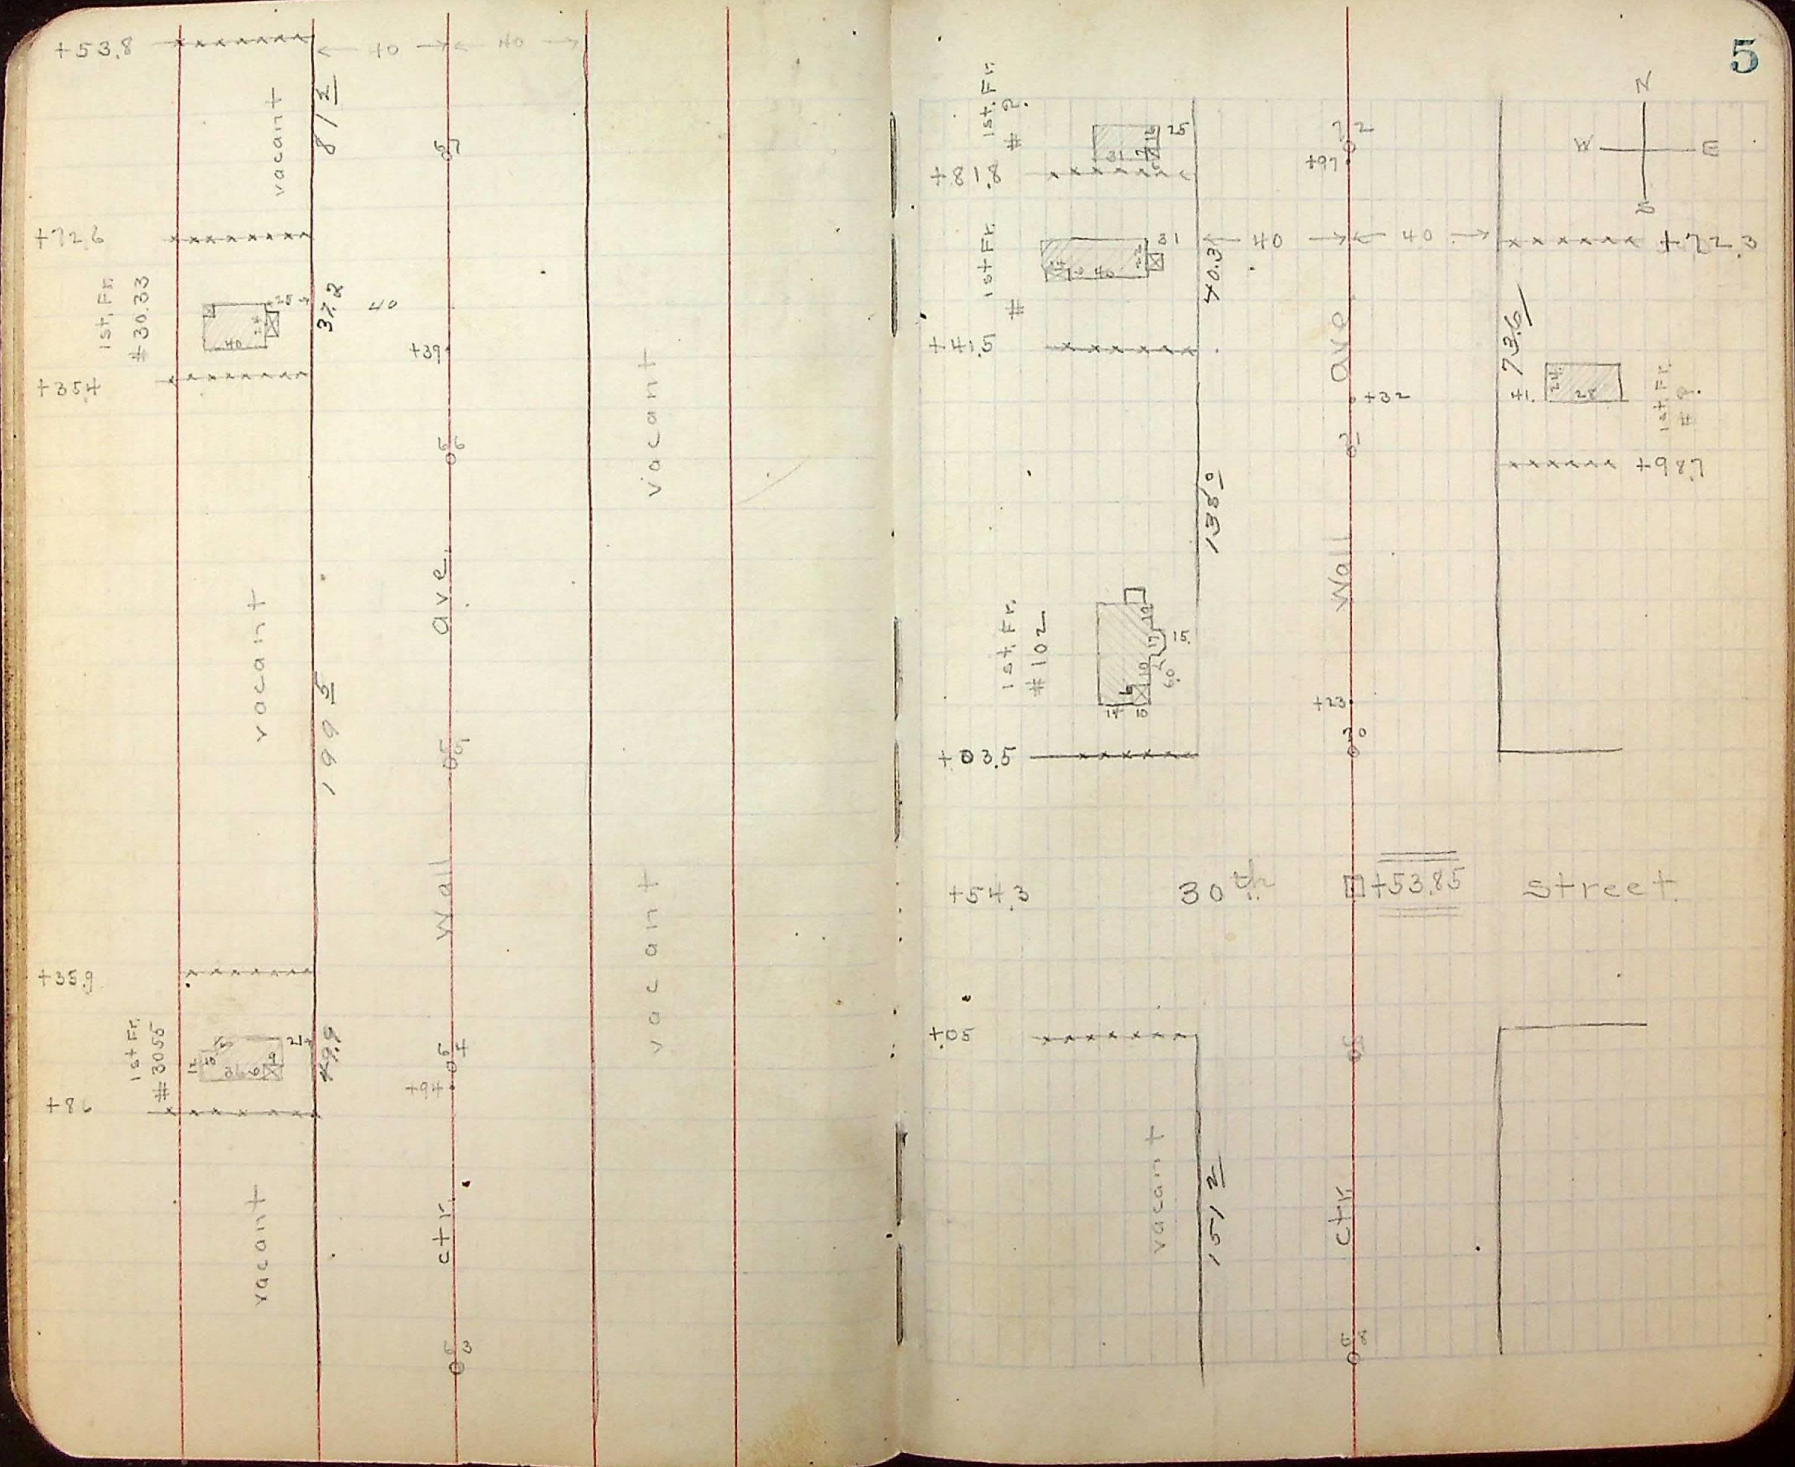
+53.8
40
40
vacant
8/12
+72.6
1st. Fr.
#30.33
37.2
40
+39
+35.4
vacant
198.5
Ave.
Wall
vacant
vacant
+35.9
1st. Fr.
#3055
29.9
+86
+94.6
vacant
ctr.
+81.8
1st. Fr.
#
+41.5
1st. Fr.
#
40.3
138.0
1st. Fr.
#102
+03.5
+54.3
30th
+53.85
street
+05
vacant
151.2
+97
40
+72.3
Ave.
7.3.6
+1.
1st. Fr.
#
+98.7
+32
Wall
+23
ctr.
N
W
E
S