

522
323
90.5



Ave

57

Grant

56

ctr

55

1st. Ex. # 2




45

+37.

32nd

□ +35.85 Street +37.07

54

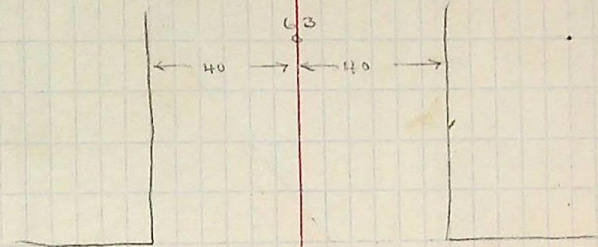


19495

31st

62

□ +9485 street +95

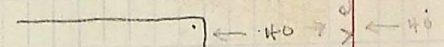

Ave

51


Grant

50

ctr


0.0000

1st. Ex. # 2

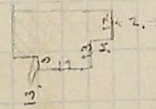

1st. Ex. #

122.3

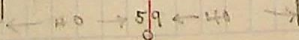

+733

+37.8