May 25 1905

Possessory lines Washington Ave
Pinoche lane to 28th st.
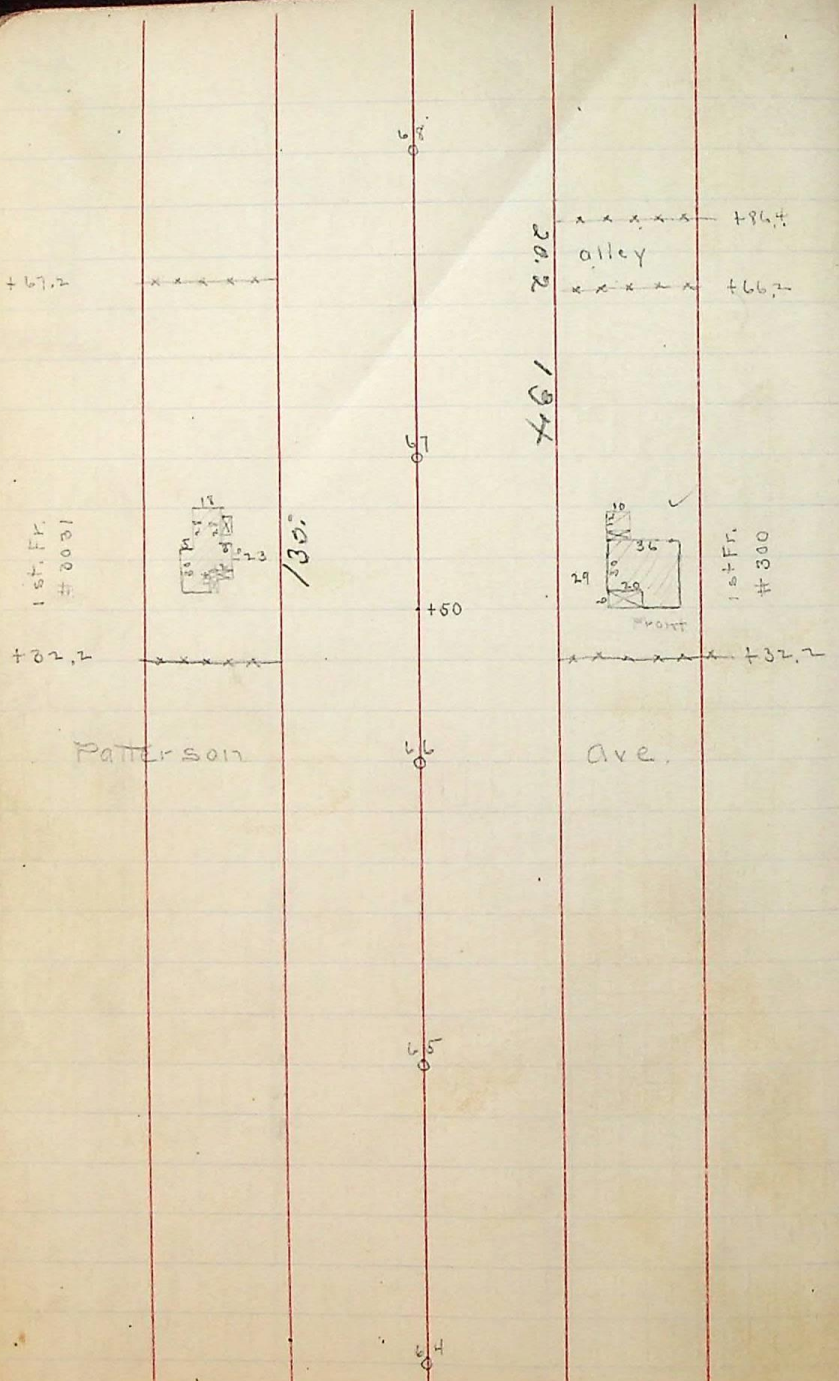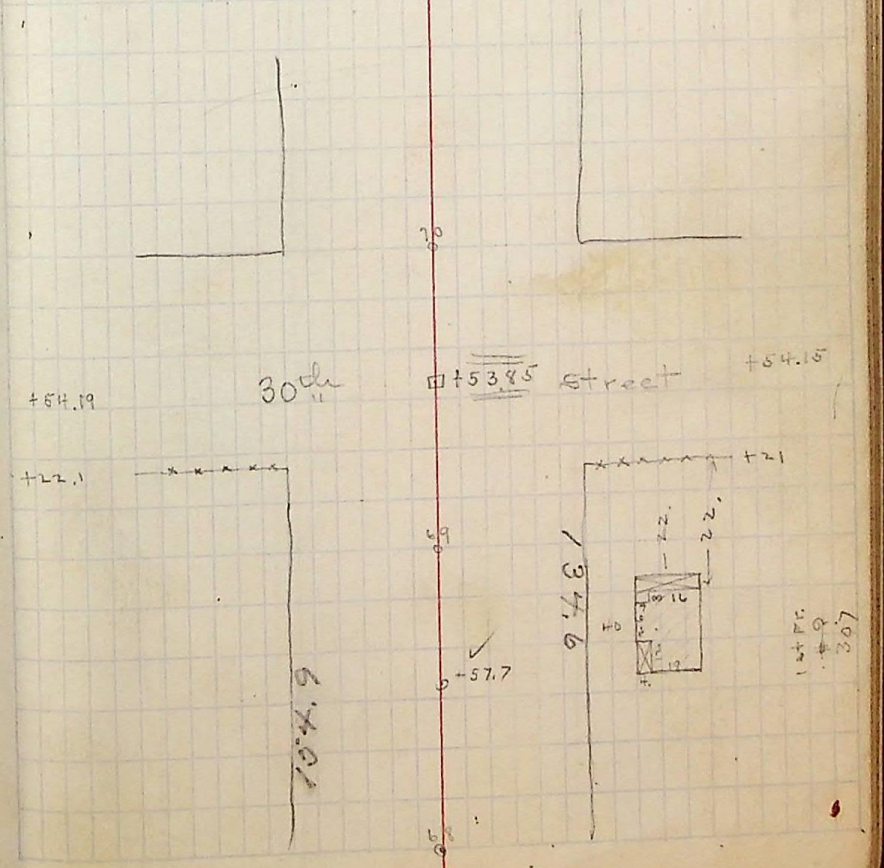
1 R.P. Inst
1 D.C. Rod } 2 P.m. to 5 P.m. May 25
1 B.S. chain } 8 a.m. to 5 " " 26
8 a.m. to 10 a.m. " 27