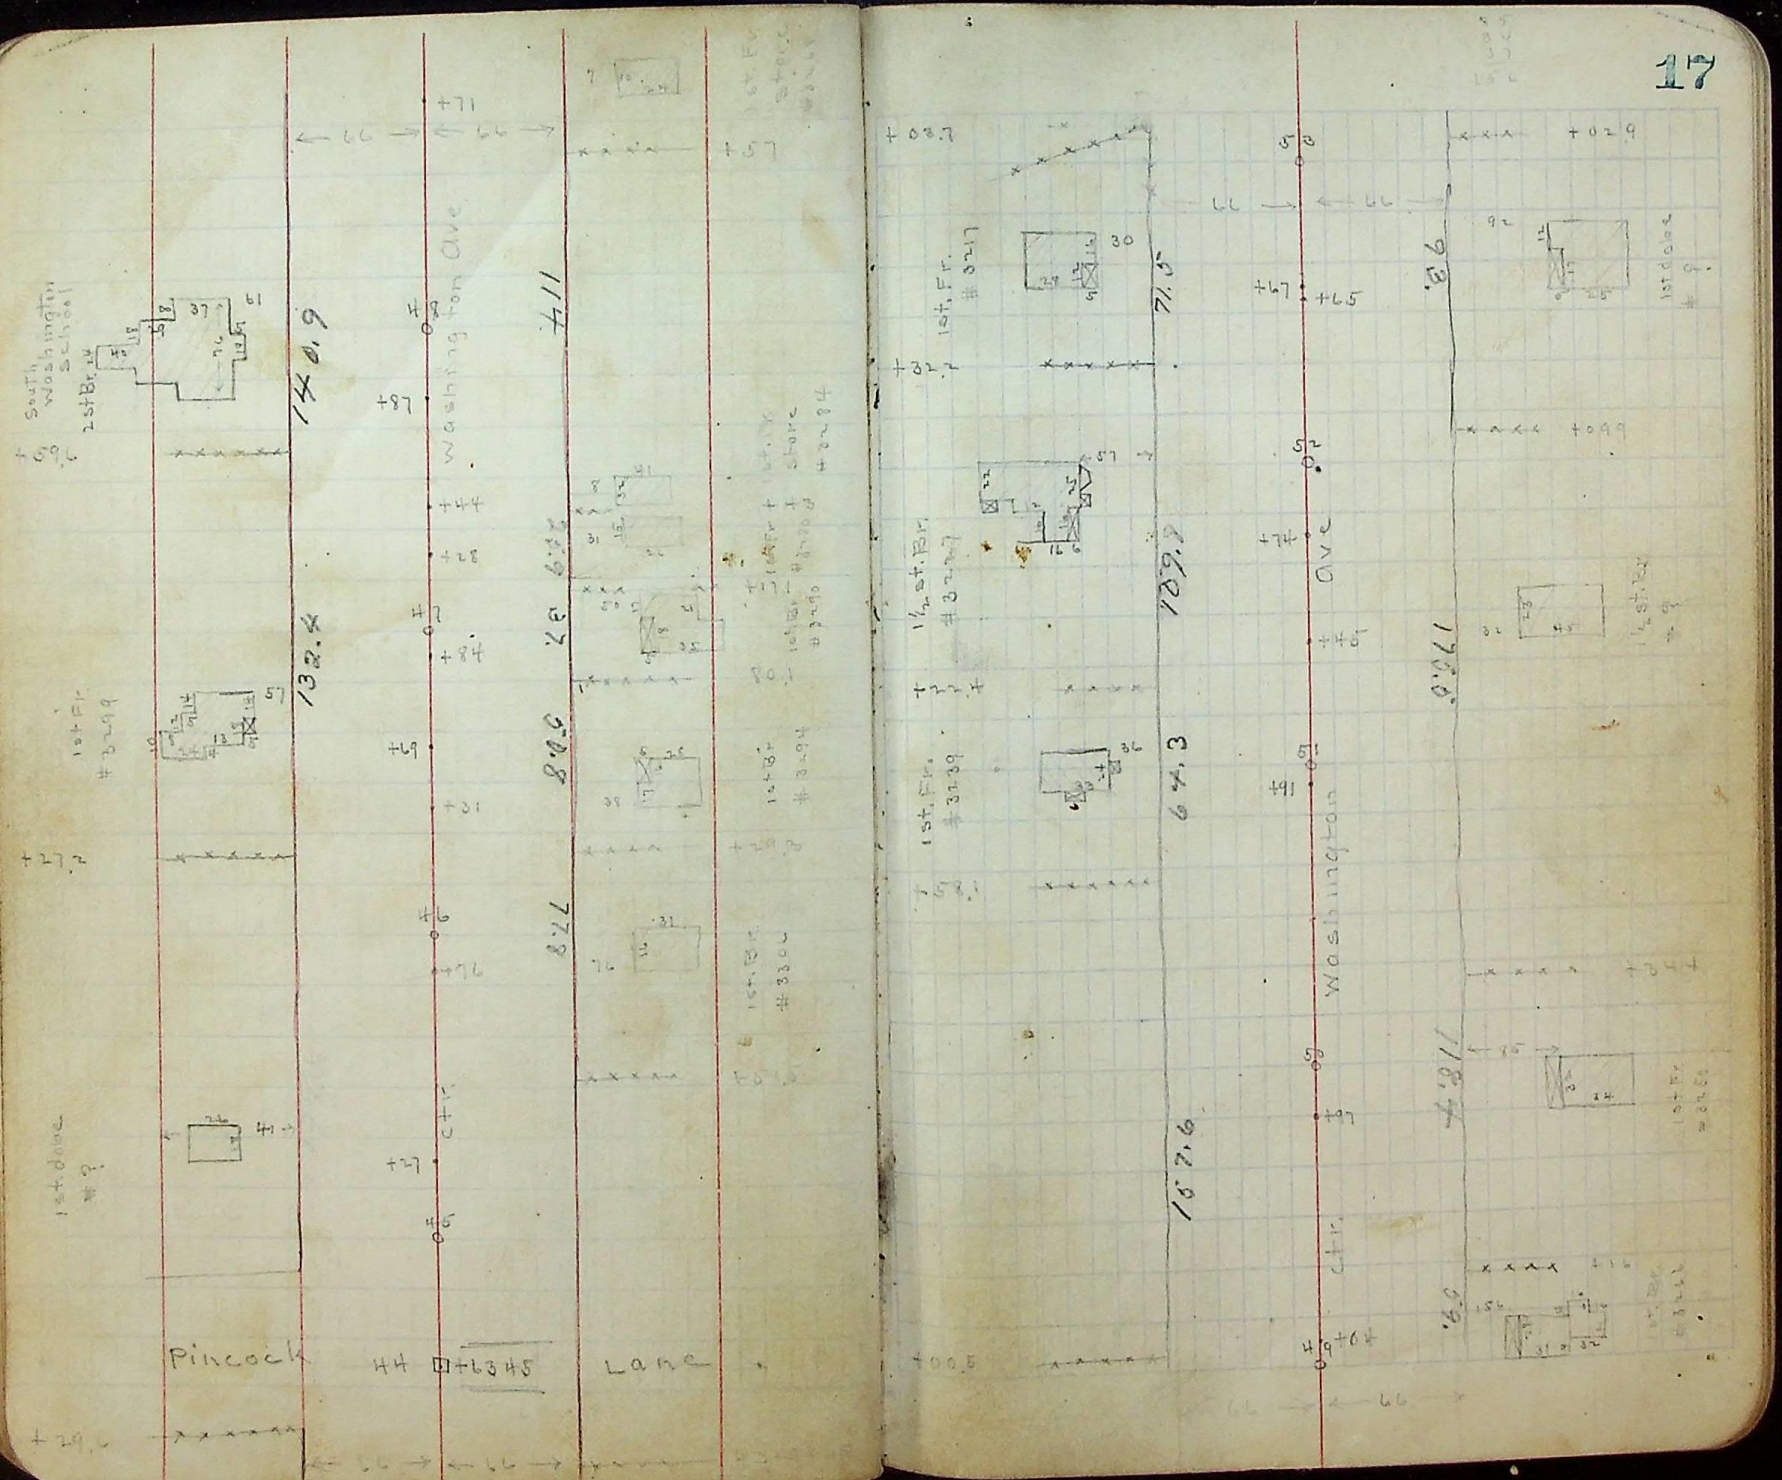
South Washington School
1st Br.
#3499
1st dwg.
#?
1st Br.
#3499
1st Br.
#3300
1st Br.
#3298
1st Br.
#3297
1st Br.
#3239
1st dwg.
#3299
1st Br.
#3299
Washington Ave
Washington Ave
Pincock
Lane
1401.9
132.4
811
826
824
826
715
189.3
643.3
+63.45