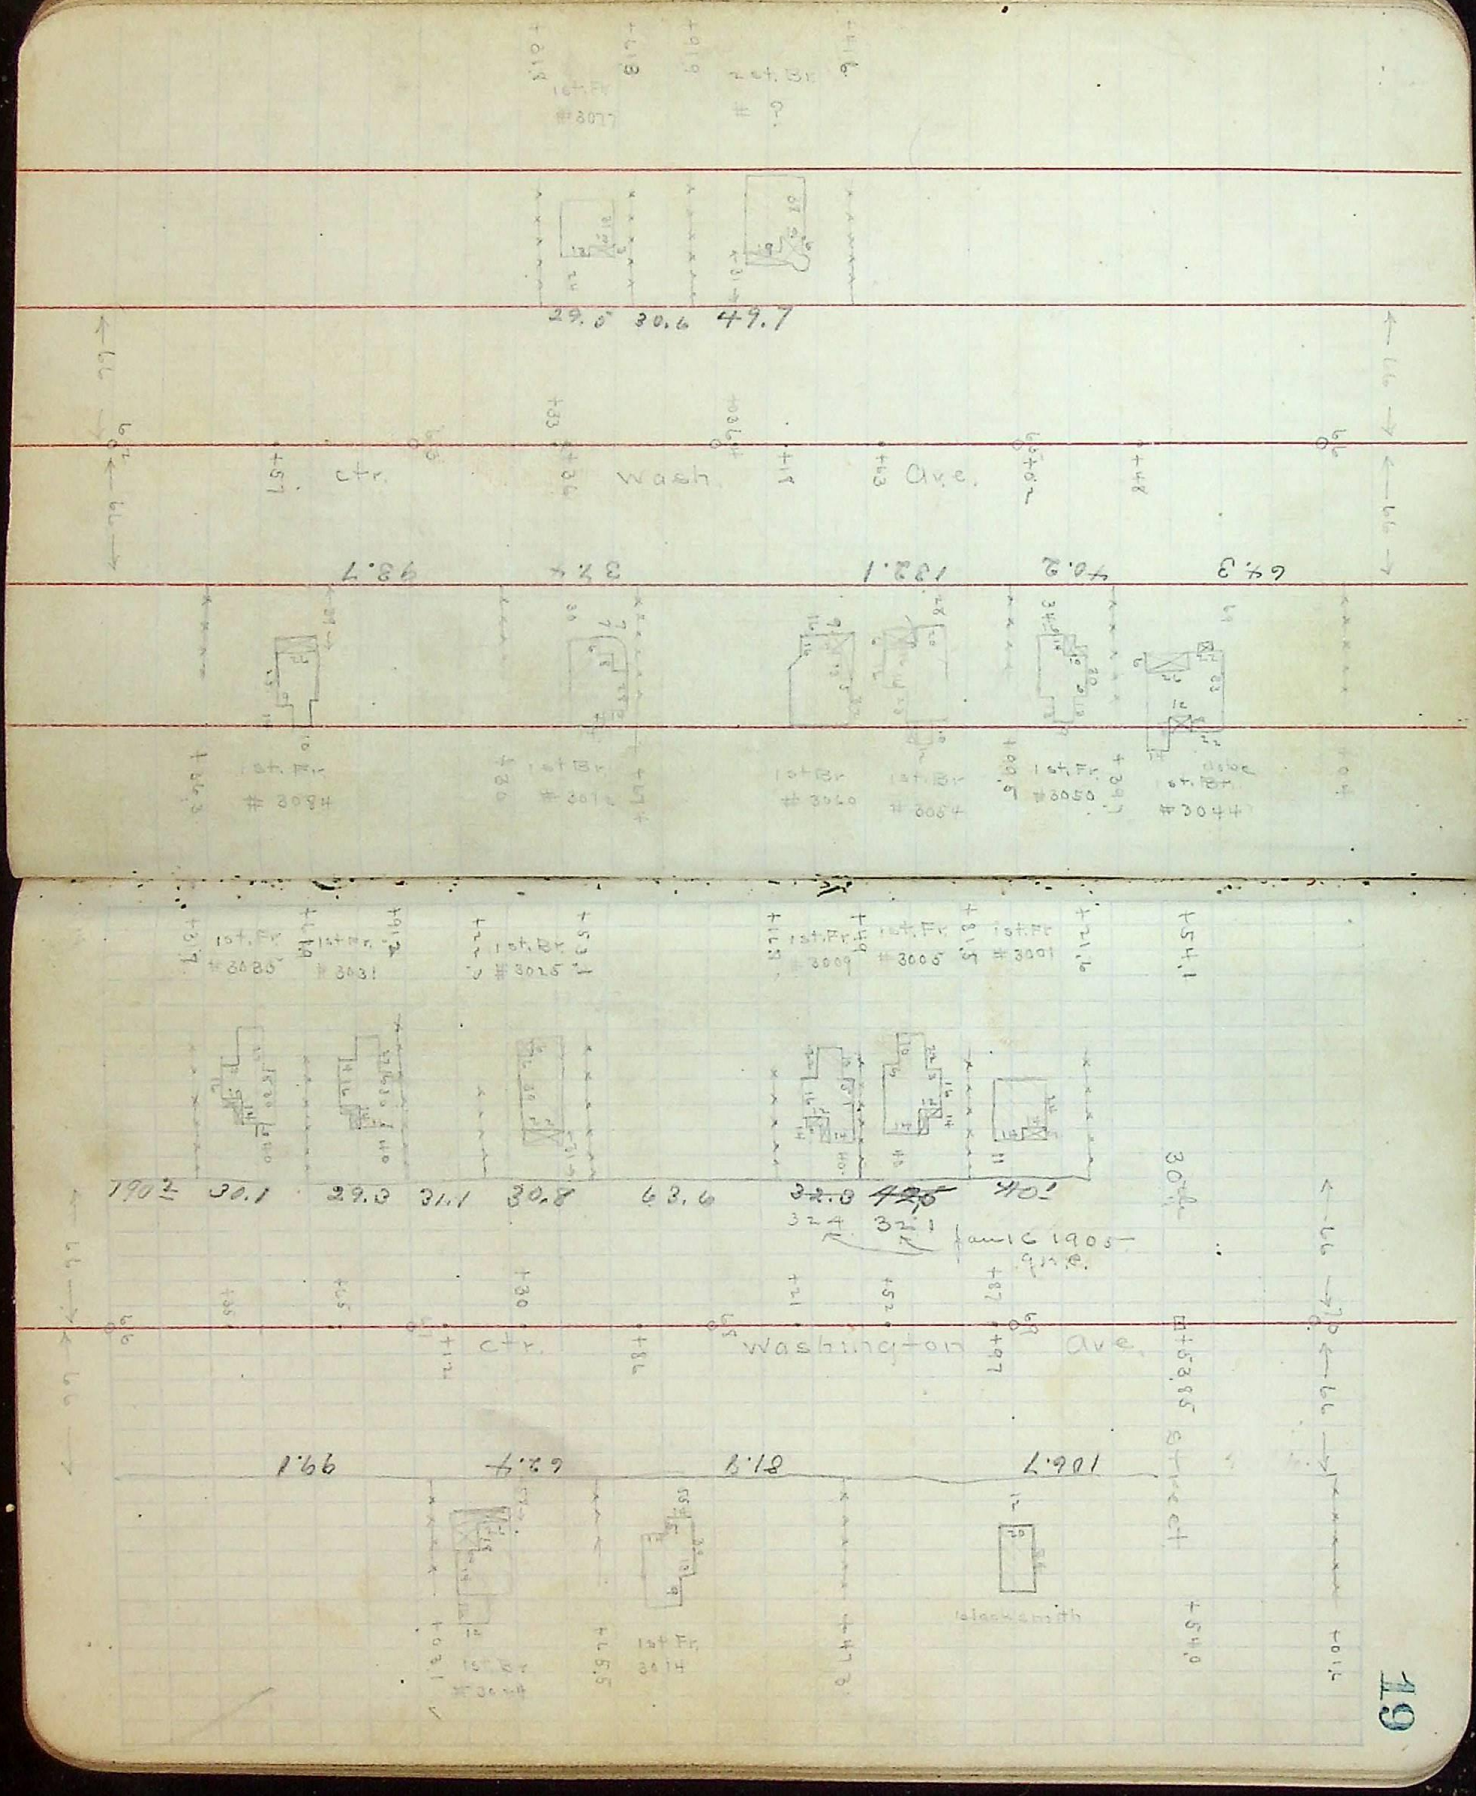
1st. Fr #3077
2 st. Br #?
29.5 30.6 49.7
1st. ctr.
Wash.
Ave.
98.7
82.1
40.2
64.3
1st Fr #3084
1st Br #3040
1st Br #3008
1st Fr #3050
Alley
1st. Br #3044
1st. Fr #3085
1st. Fr #3031
1st. Br #3025
1st. Fr #3009
1st. Fr #3005
1st. Fr #3001
190± 30.1 29.3 31.1 30.8 63.6 32.8 40±
32.4 32.1
Jamic 1905 — 9 1/2 R.
30±
1st. ctr.
Washington Ave.
166 47.9 81.8 190.7
1st. Br #3014
1st Fr 3014
Blacksmith
Alley