


Wall 76 + #902 ave.

July 26 1965

Possessory line on 31st Street

Wall to Jeff. ave.

9th St }
 1st B.C. chain } 20m to 50m July 7
 2nd B.C. chain }

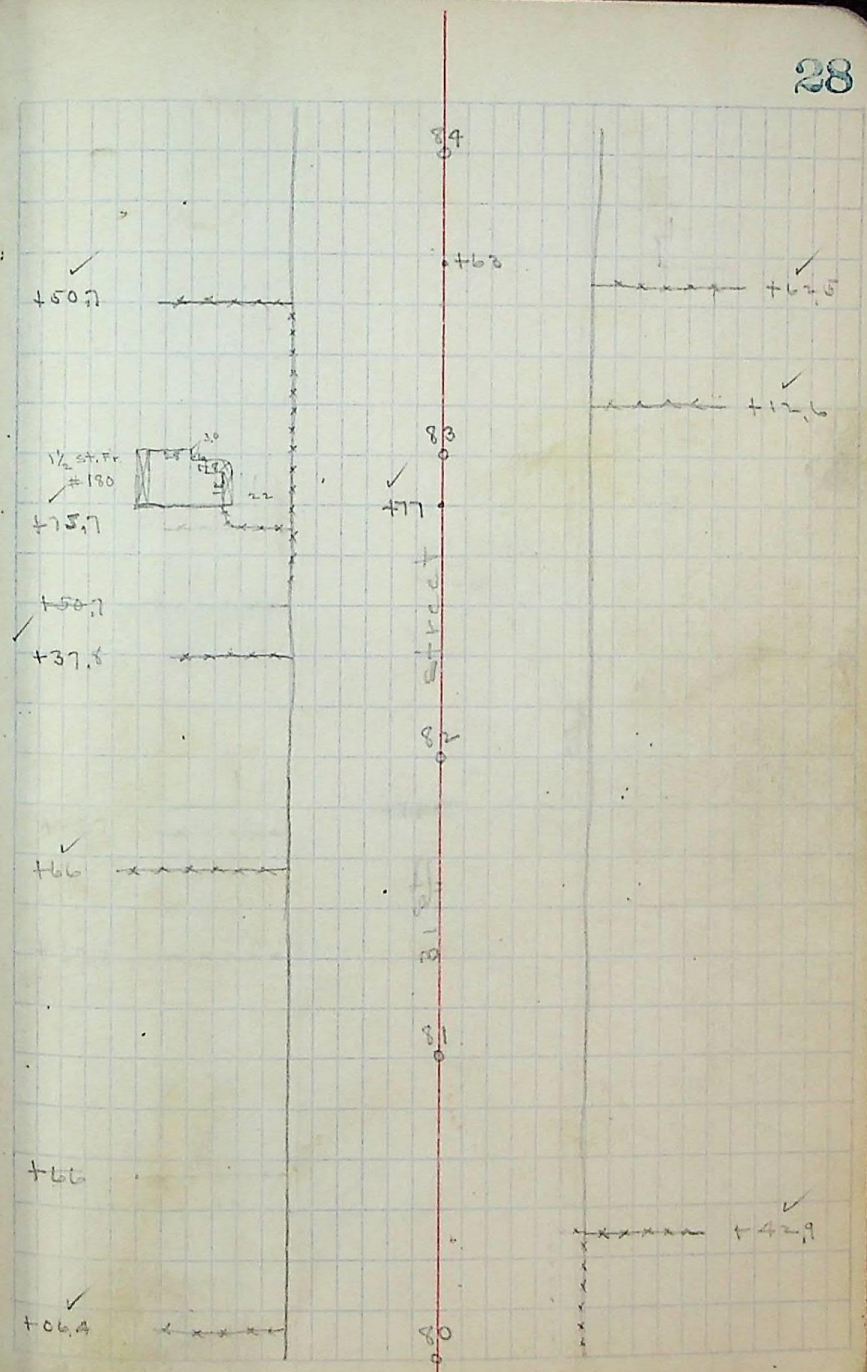





