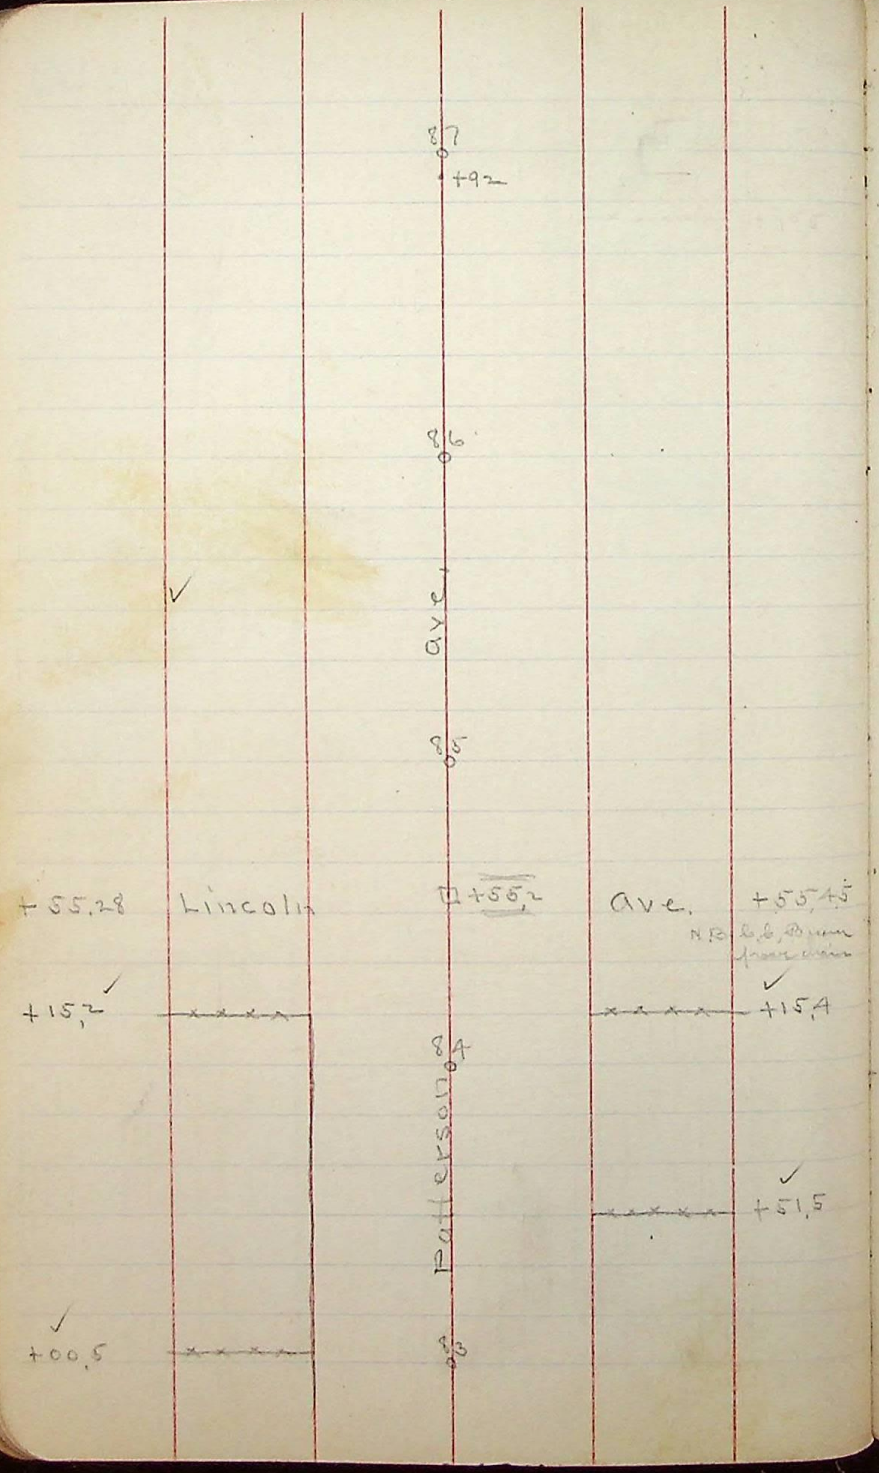
87
+92
86
Ave.
85
+55.28
Lincoln
+55,2
Ave.
+55,45
N.B. Lab. Brum from corner
+15,2
+15,4
84
Patterson
+51,5
+00,5
83

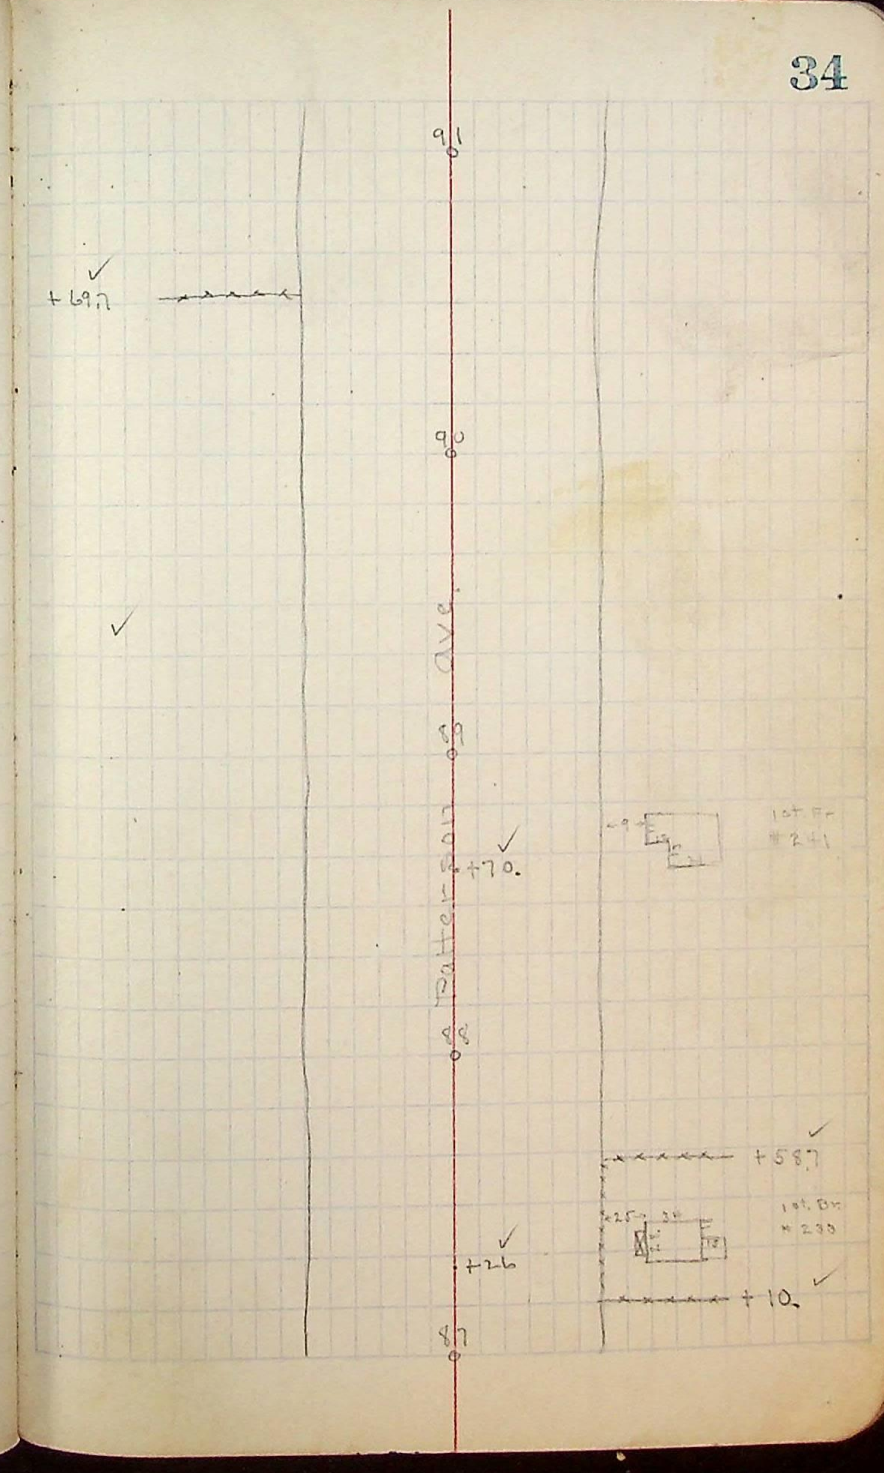
91
+69,7
90
Ave.
89
Patterson
+70.
88
1st Bk N 241
+58,7
1st Bk N 233
+26
+10.
87