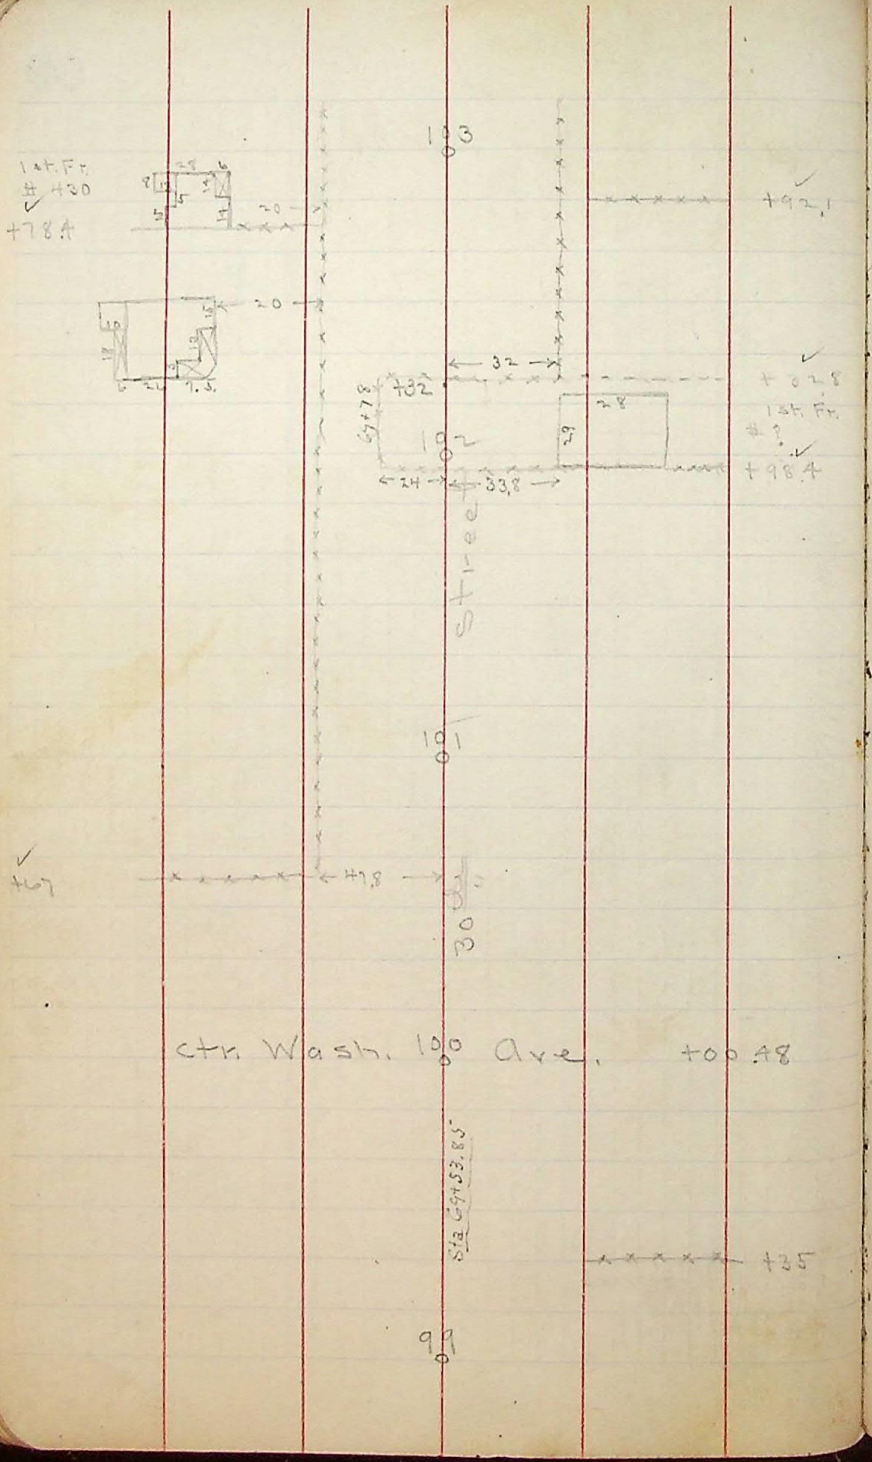
1st. Fr. # 430
+78.4
103
+92.1
20
32
+32
+32.8
1st. Fr. # ?
+98.4
102
24
33.8
Street
101
+67
47.8
30
ctr. Wash. 100 Ave. +00.48
Sta 69+53.85
+35
99

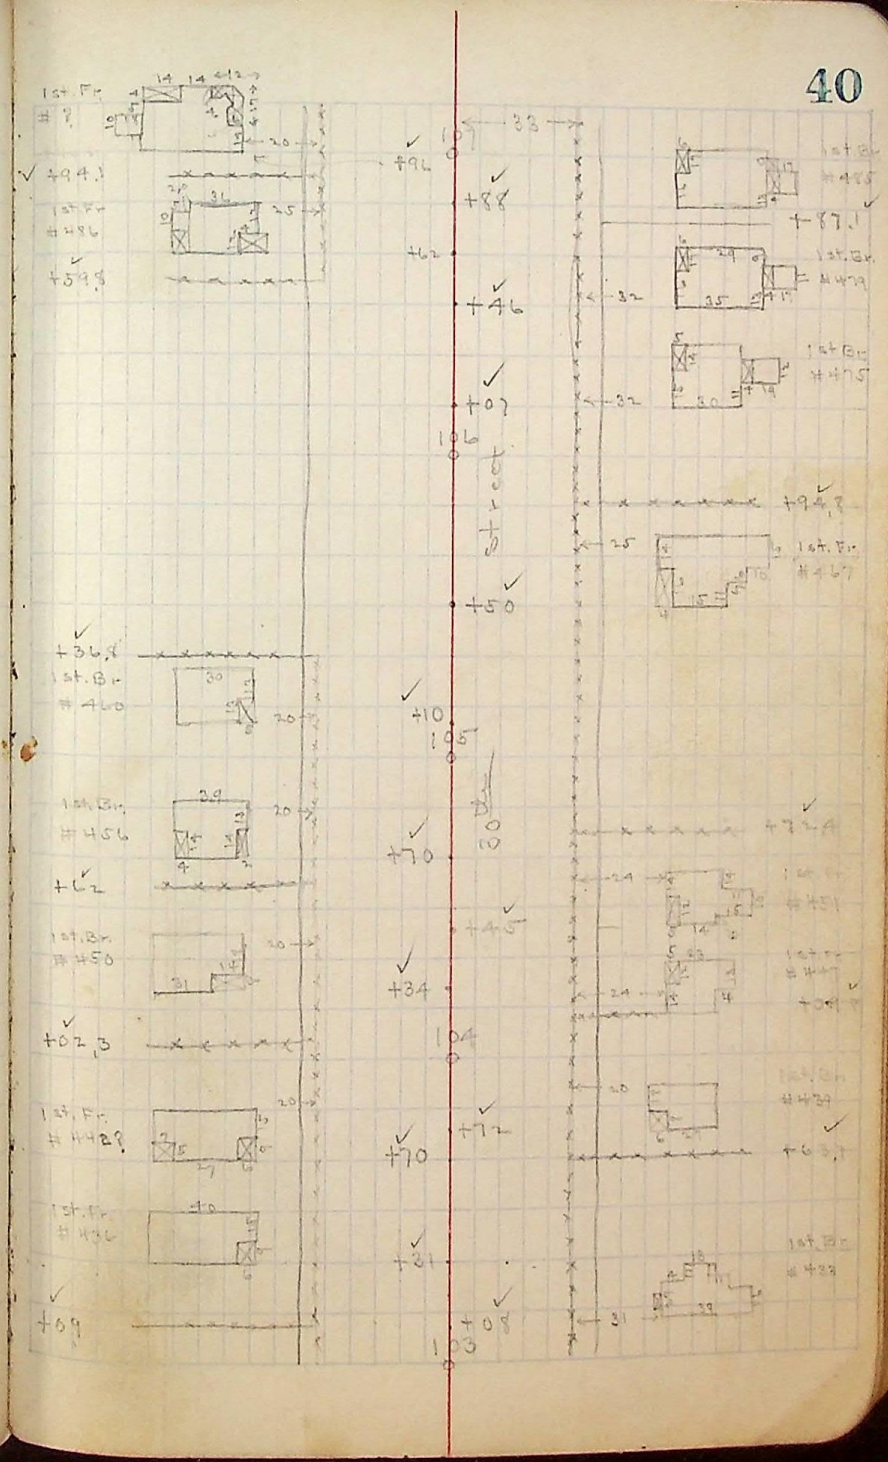
1st. Fr. # ?
+94.1
1st. Fr. # 486
+59.8
+96
107
33
+88
+62
+46
+07
106
Street
+50
+36.8
1st. Br. # 460
+10
105
1st. Br. # 456
+62
+70
+45
1st. Br. # 450
+34
104
+02.3
1st. Fr. # 442?
+72
+70
1st. Fr. # 436
+31
+09
+08
103
1st. Br. # 485
+87.1
1st. Br. # 479
1st. Br. # 475
+94.8
1st. Fr. # 467
+72.4
1st. Br. # 451
1st. Br. # 439
1st. Br. # 433