

N.B. House stands in ctr. of st.
on this 1/2 block.

84

83

82



81

Ring st


✓
+46.6

80

ave.

557
96.3

42

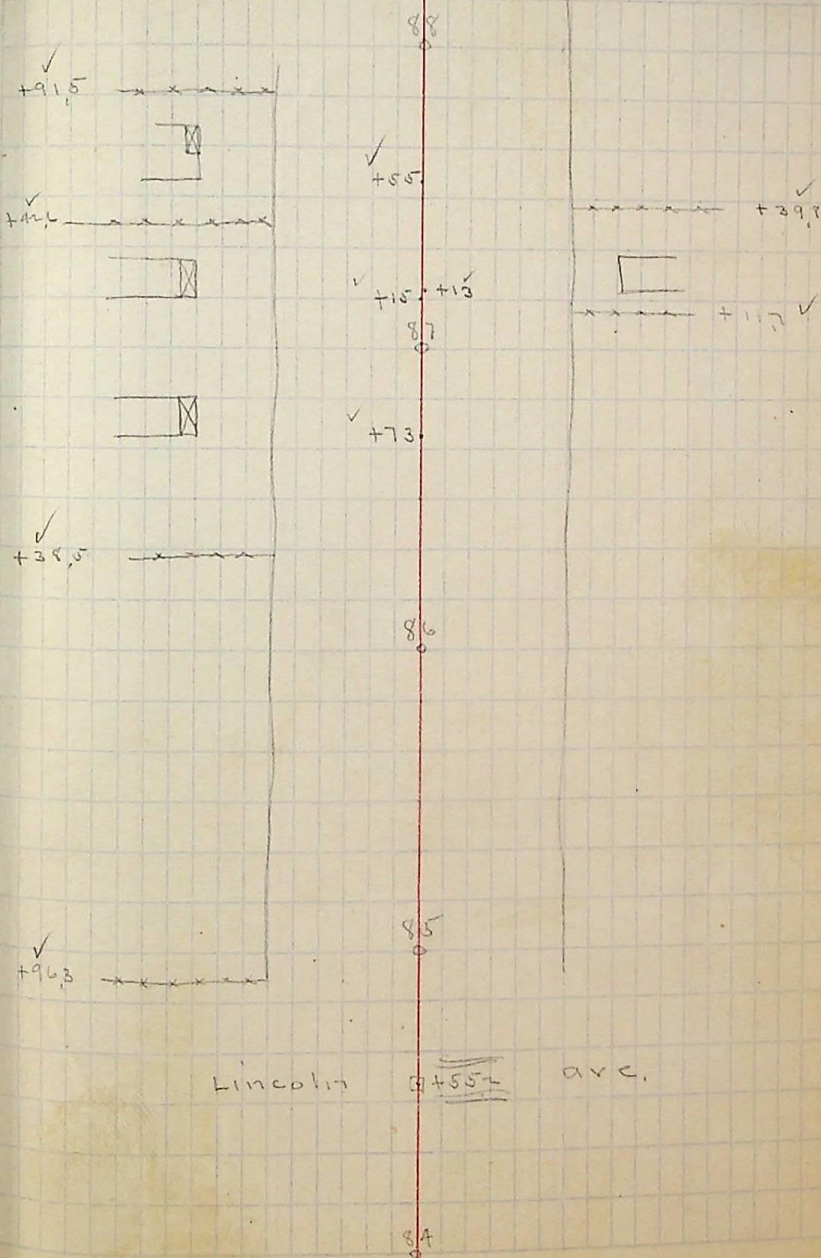

88

✓
+91.5

✓
+55

✓
+44.6

✓ +5. +13

✓
+39.7

87



✓
+73

✓
+11.7

✓
+38.5

86

85

✓
+96.3

Lincoln 5+55.2 ave.

84