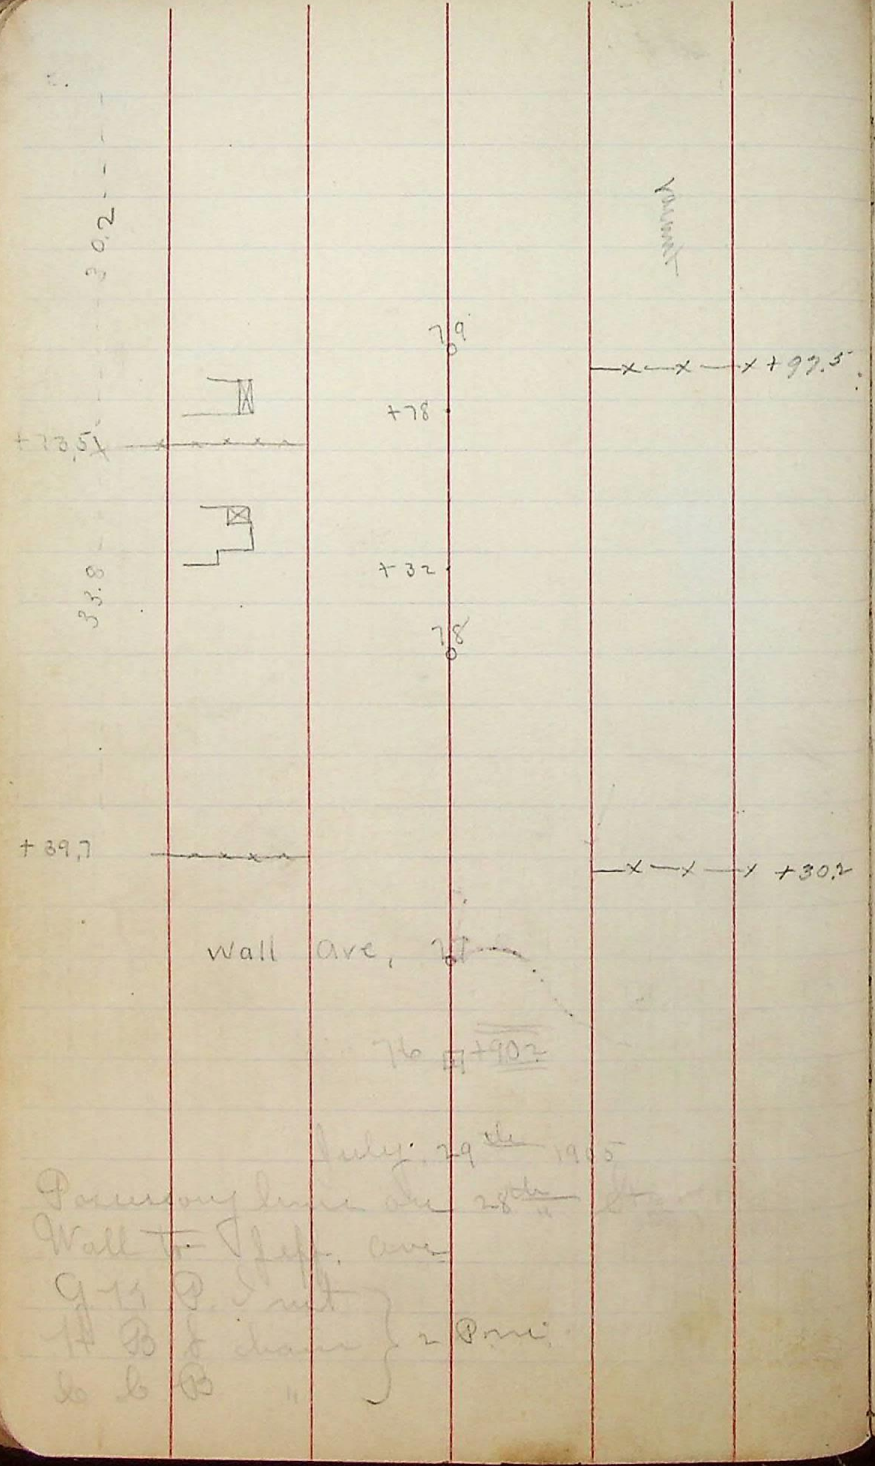
30.2
79
+78
+99.5
+73.5
+32
33.8
78
+39.7
+30.2
Wall Ave, 78
78 to +90.2
July 29th 1915
Pavement line Ave 28th St
Wall to Left Ave
9-11 P. Int
14 80 to Ave } 2 Pave
to 6 80 "

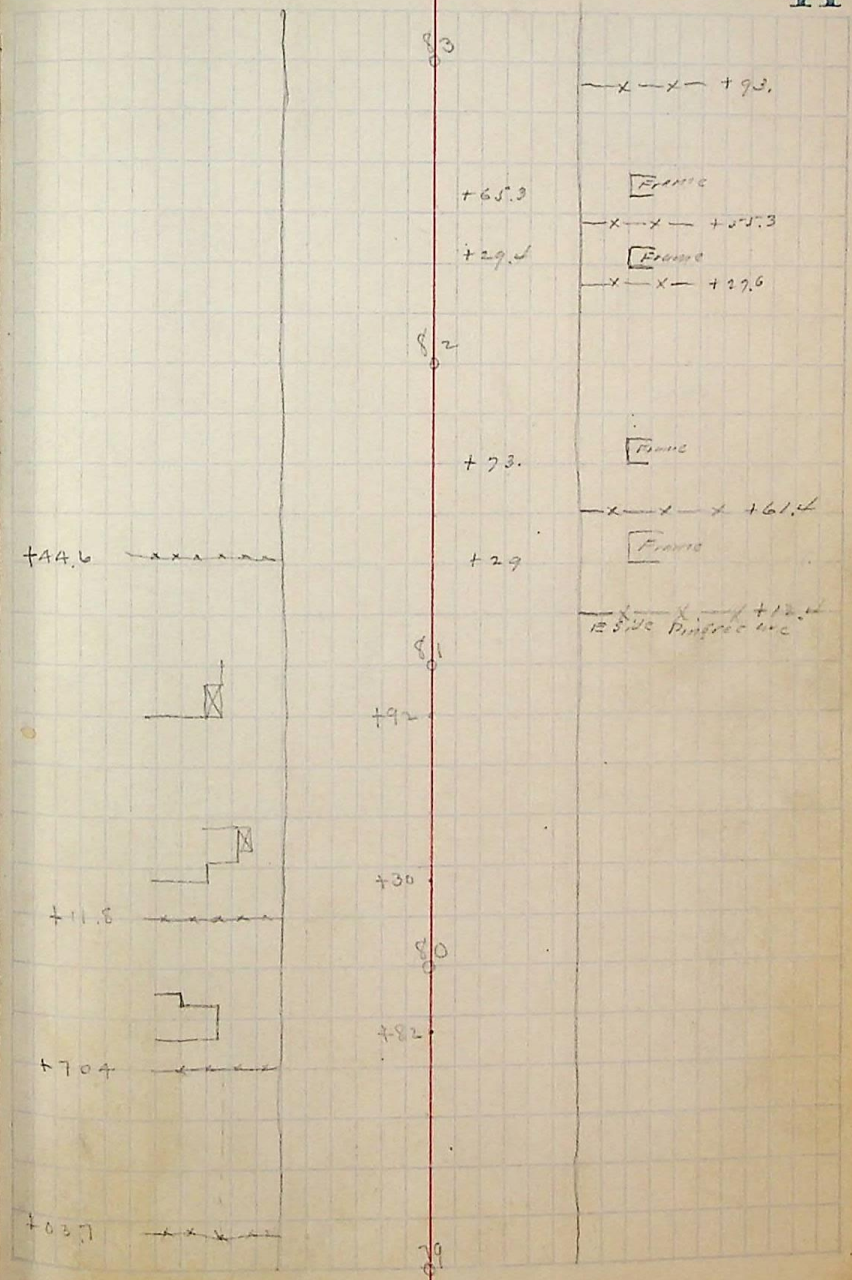
83
+65.3
+29.4
82
+73.
+44.6
+29
81
+92
+11.8
+70.4
+63.7
79
+93.
Frame
+65.3
+29.6
+161.4
+12.4
Pavement Ave
80
+82
+30