




May 14 1889

From Center of 28th
532' to fence

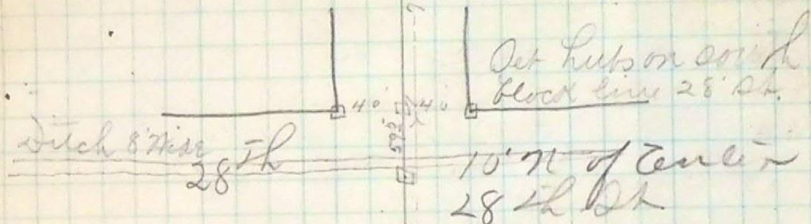


A. F. PARKER,

27th

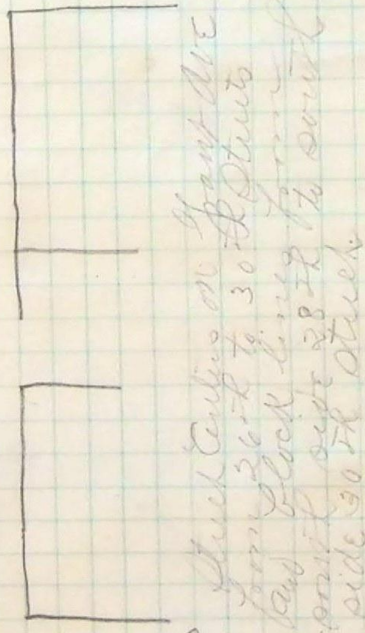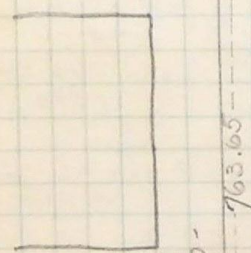

Shed built on Grant Ave
from 26th to 30th Streets
and block line to corner
south side 28th to south
side 30th street

26th

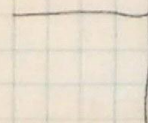

B. 23

Grant Ave

7th
Channing Ave
with tall sand