

May 16th 1889

9

Line checking up Ellis survey of Central Park

note:

Meas. done with steel bands


A. F. PARKER.

Point on East side of
street car track

Iron spike probably set by Jenkins

Washington Ave.

123
D. 1

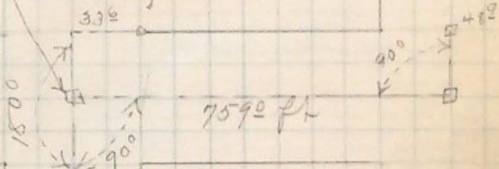

3045 ft

31st St.

Bratt Ave.