May 18th 1889 — May 24th 1889
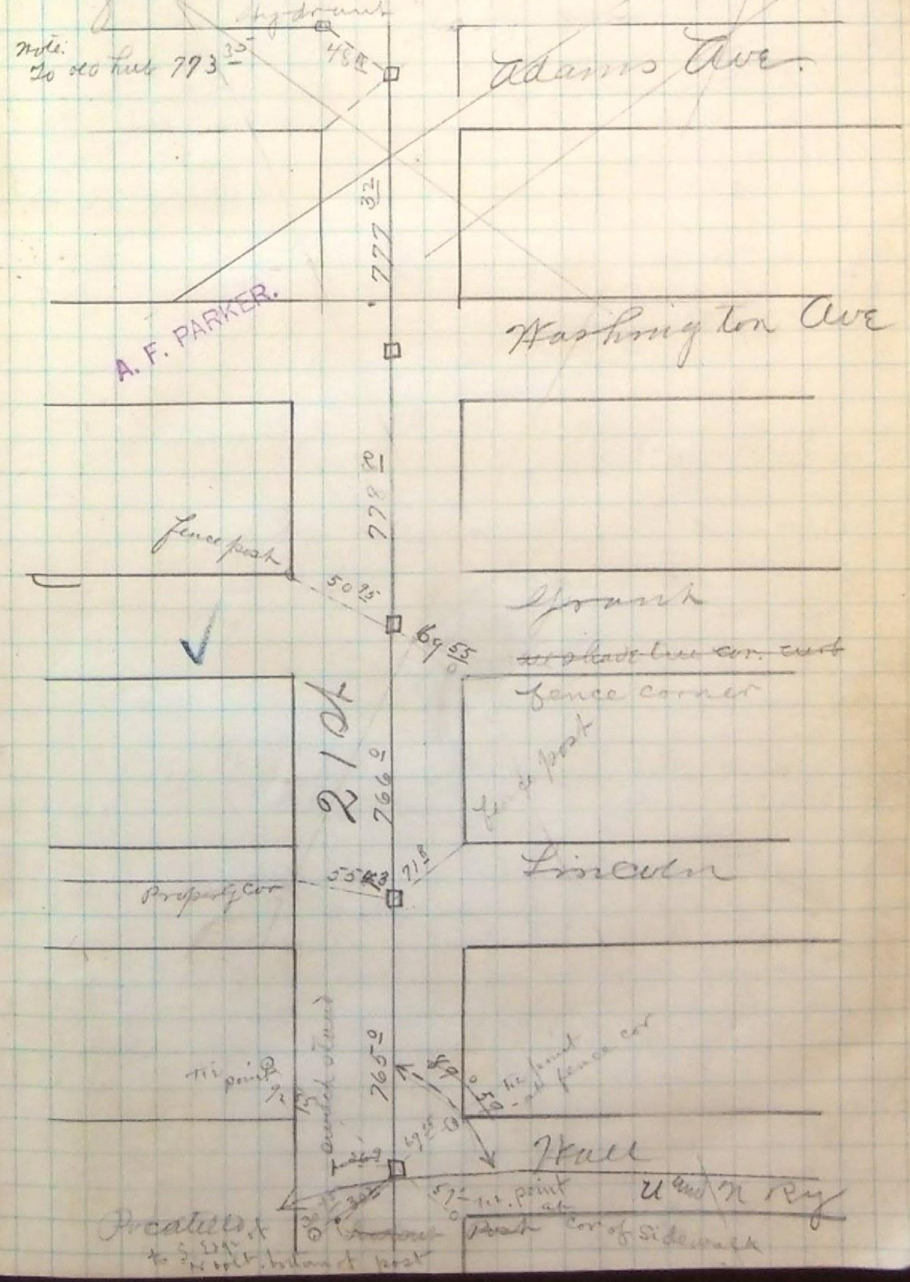
Hubs on 21st St. at intersection of Cross Streets from which to