

May 20th 1889

15.

Black Centers on
21st St.


Abandoned

A. F. PARKER.


Thorn did not check
out

This hut some 69 ft west of
hut and from Washington
ave. May 18th


Jefferson

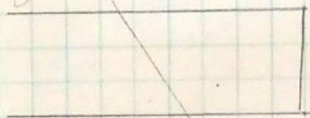


760 50

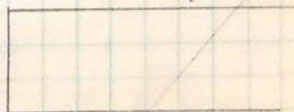


Madison

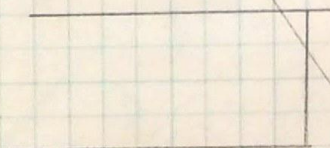


771 20

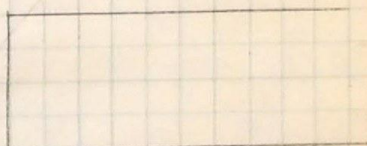


Monroe

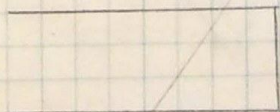


772 84

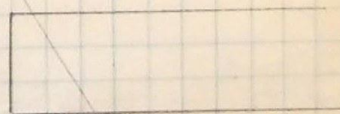

Cumey

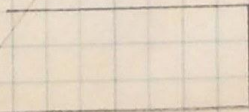

758 92

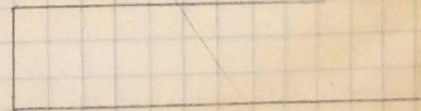

Jackson



monument

