


June 4 Waterfall Canon

A. F. Pittner

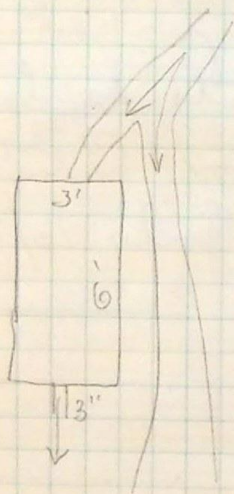

Waterfall Canon.

Pipe taking about  
 $\frac{1}{4}$  of stream