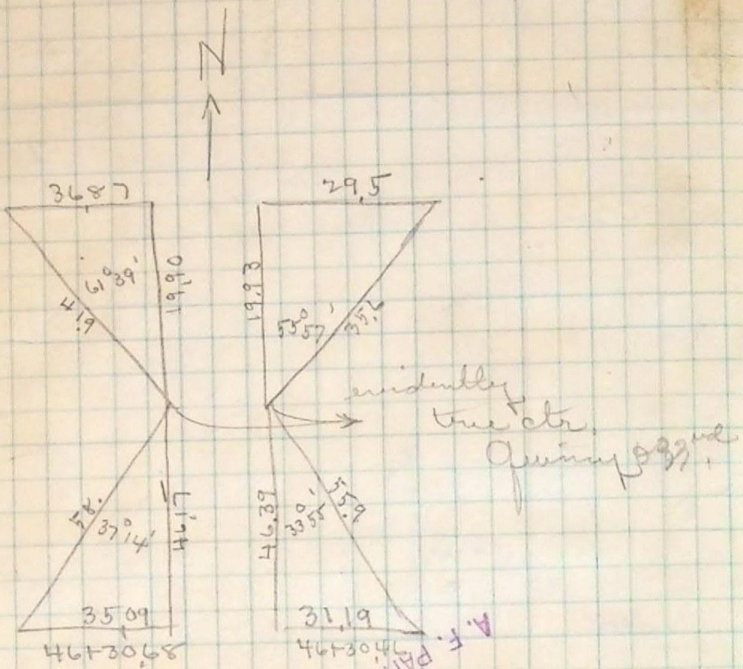
N
36.87
29.5
19.90
19.93
4.19
55° 57'
35.2
evidently true ctr.
Opening 99.33
46.39
35.09
31.19
A. F. PARKER
Cal. June 13 - 1914
J. H. B.