


June 18<sup>th</sup>

65

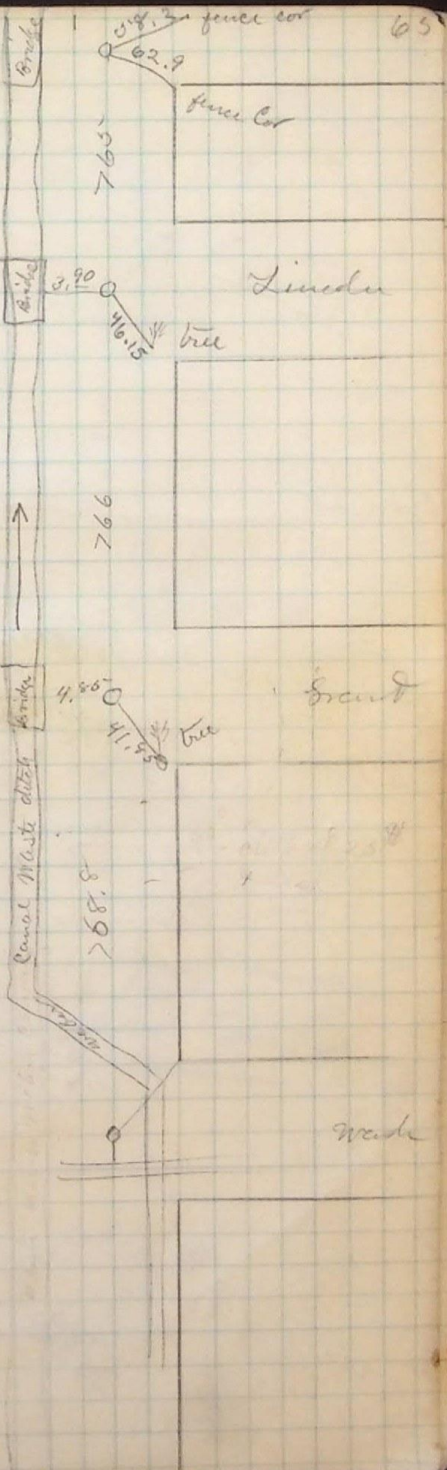

A. F. PARKER.

B25