


30th

St.

(91)

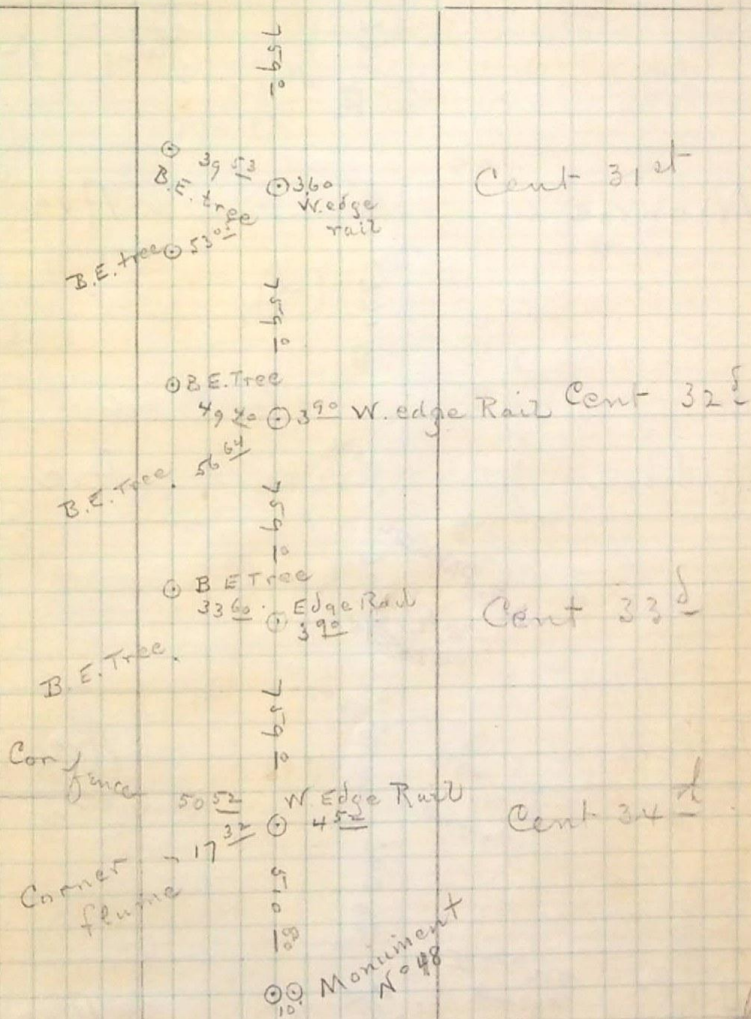

A. F. PARKER.

July 27th
 Continuation of
 10' offset-hubs on
 Washington Ave
 See p 89