

99  
99  
Mark Ave

30<sup>th</sup>  
776 82


A. F. PARKER.

31<sup>st</sup>

Sat - Aug 3<sup>d</sup> 1889

32<sup>d</sup>

33<sup>d</sup>

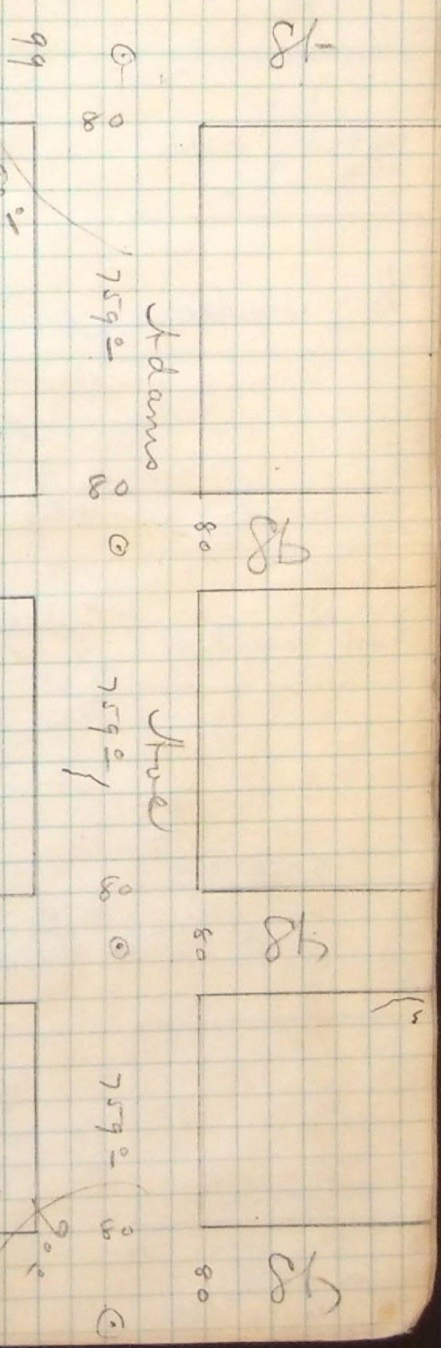

81-

Adams


80 86

80 85

80 85

99

99

80

759-

80

80

759-

80

80

759-

80

80

90

90

90