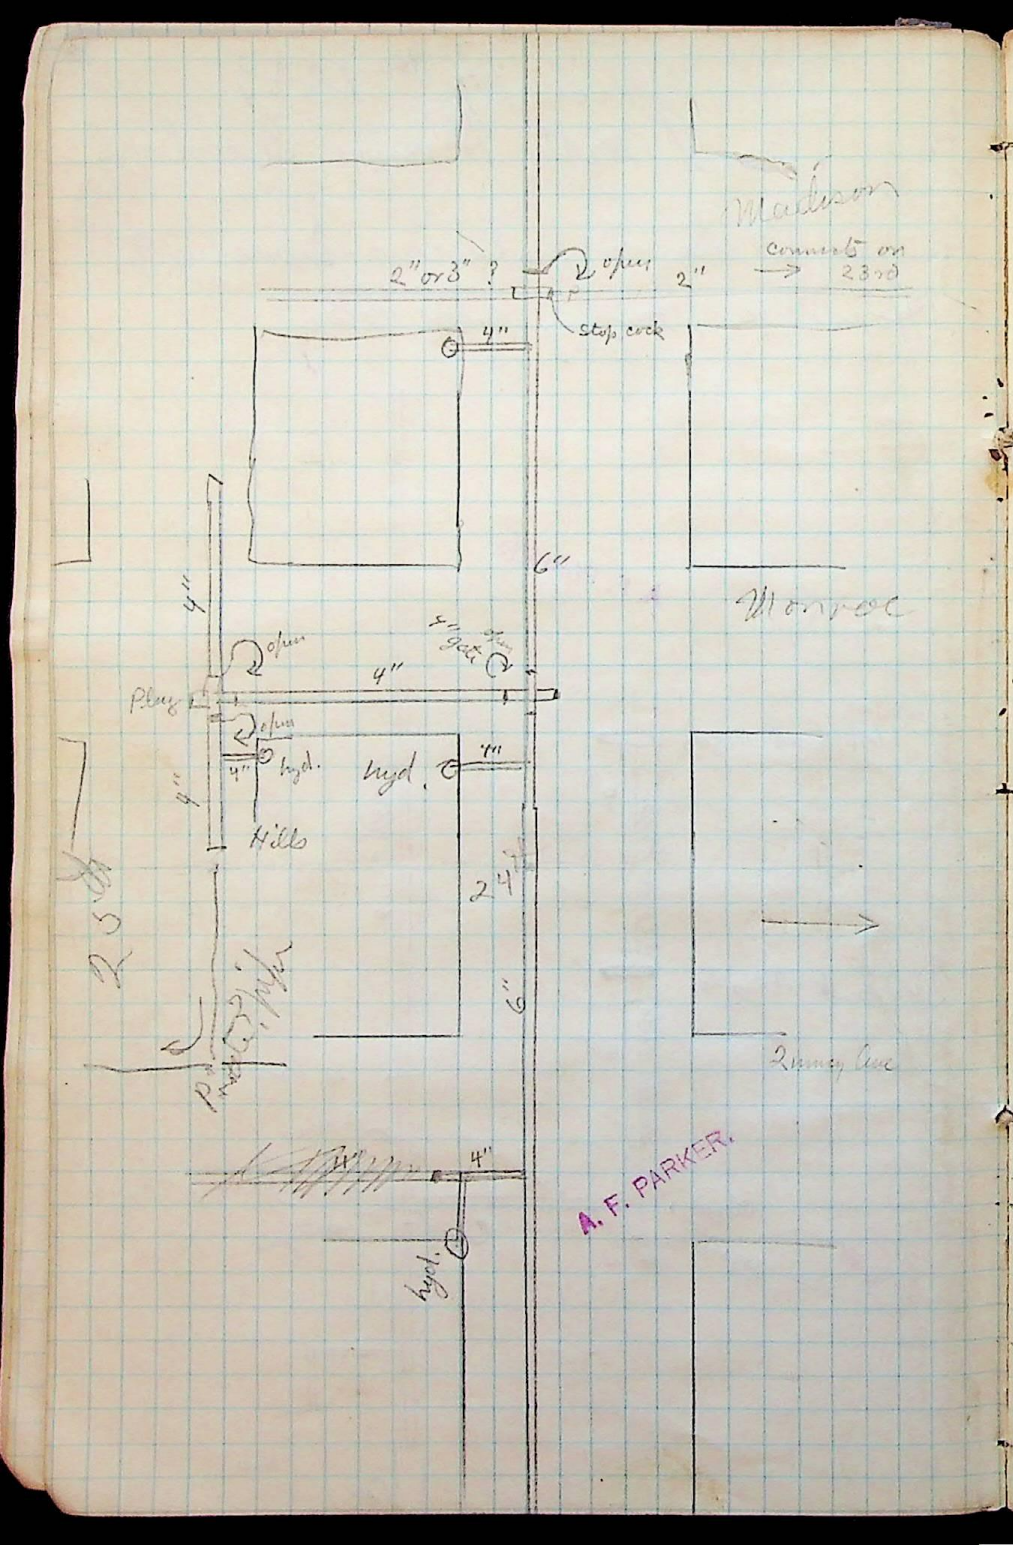
Madison
connects on 23rd
2" or 3" ?
open
2"
stop cock
4"
6"
Monroe
4"
open
4" gate
Plug
4"
hyd.
hyd.
4"
Hills
24th
6"
25th
Private pipe
2 mines line
4"
hyd.
A. F. PARKER.

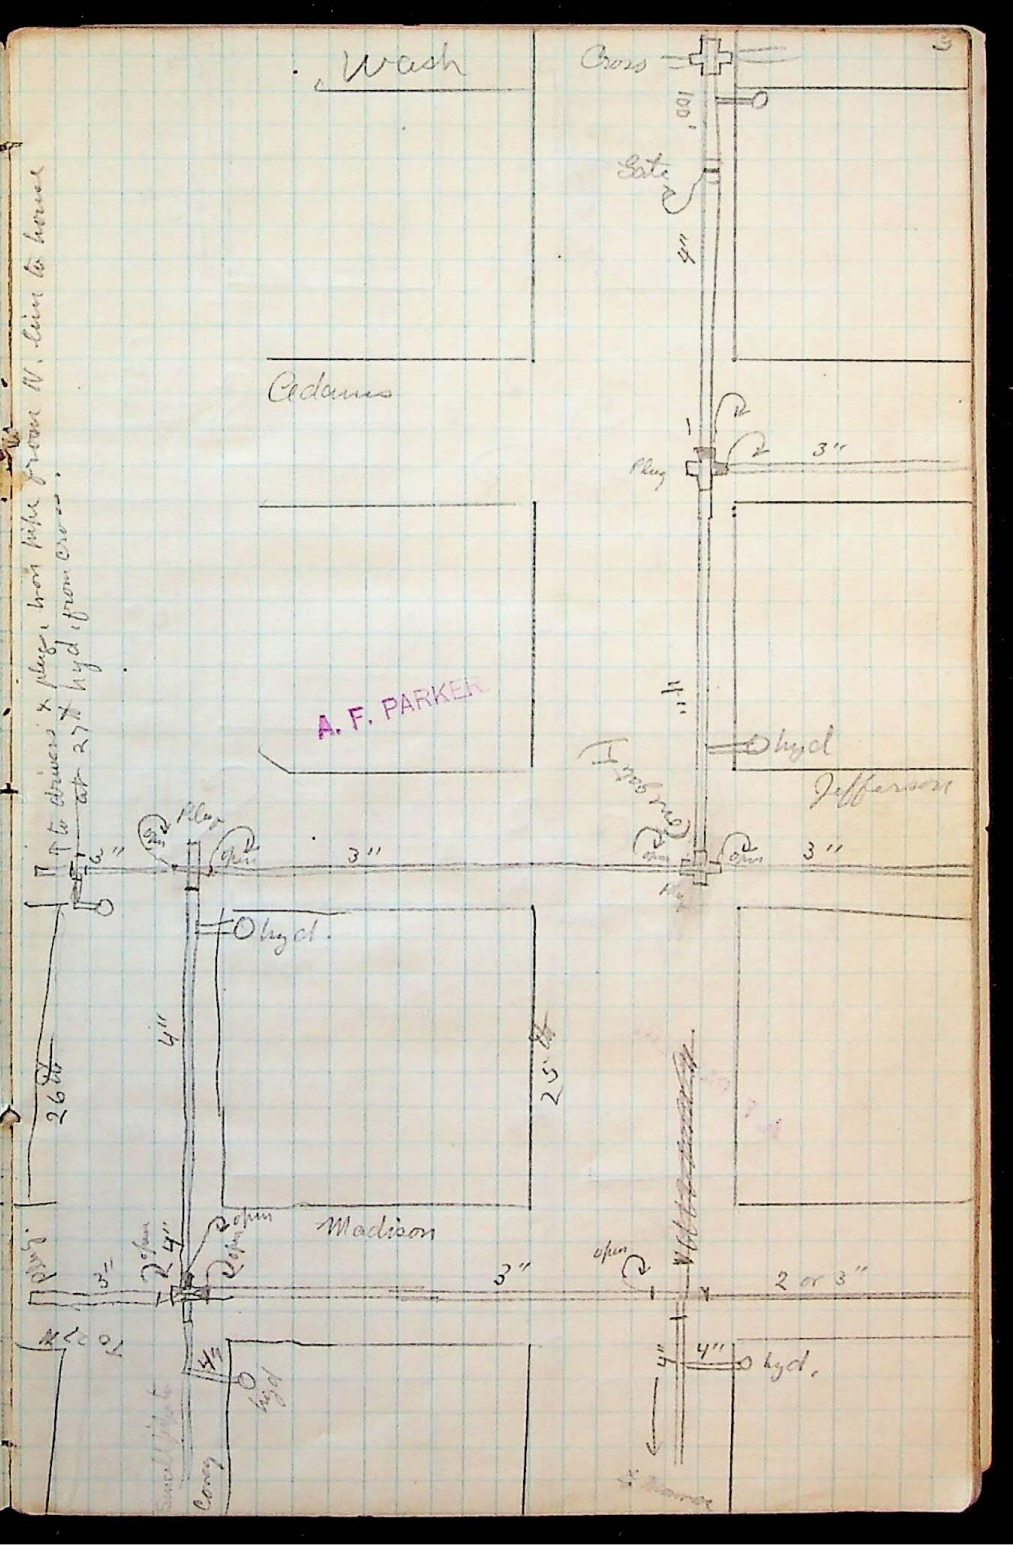
Wash
Cross
100'
Gate
4"
Adams
Plug
3"
A. F. PARKER
hyd
Jefferson
to drivers x plug, iron pipe from W. line to house at 27th hyd from cross
Plug
3"
3"
3"
hyd.
4"
26th
25th
Madison
3"
open
4"
open
3"
open
2 or 3"
4"
hyd.
4"
hyd
Coney
Monroe