

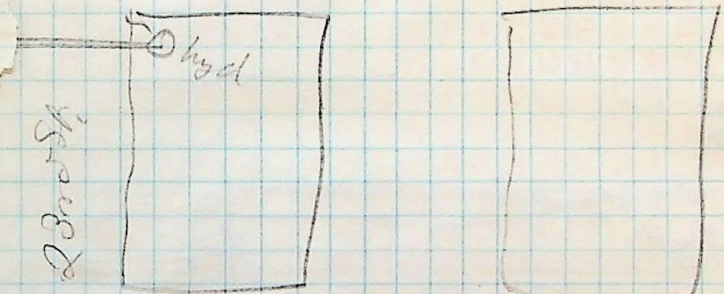
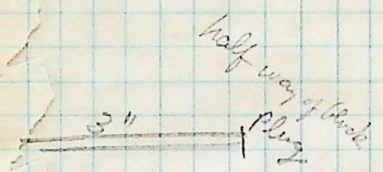


Wash

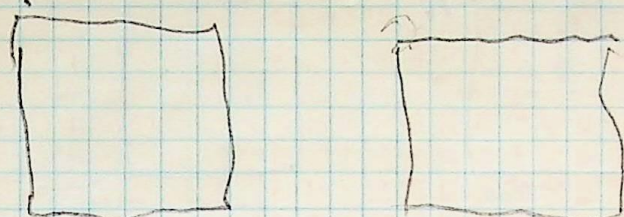

A. F. PARKER.

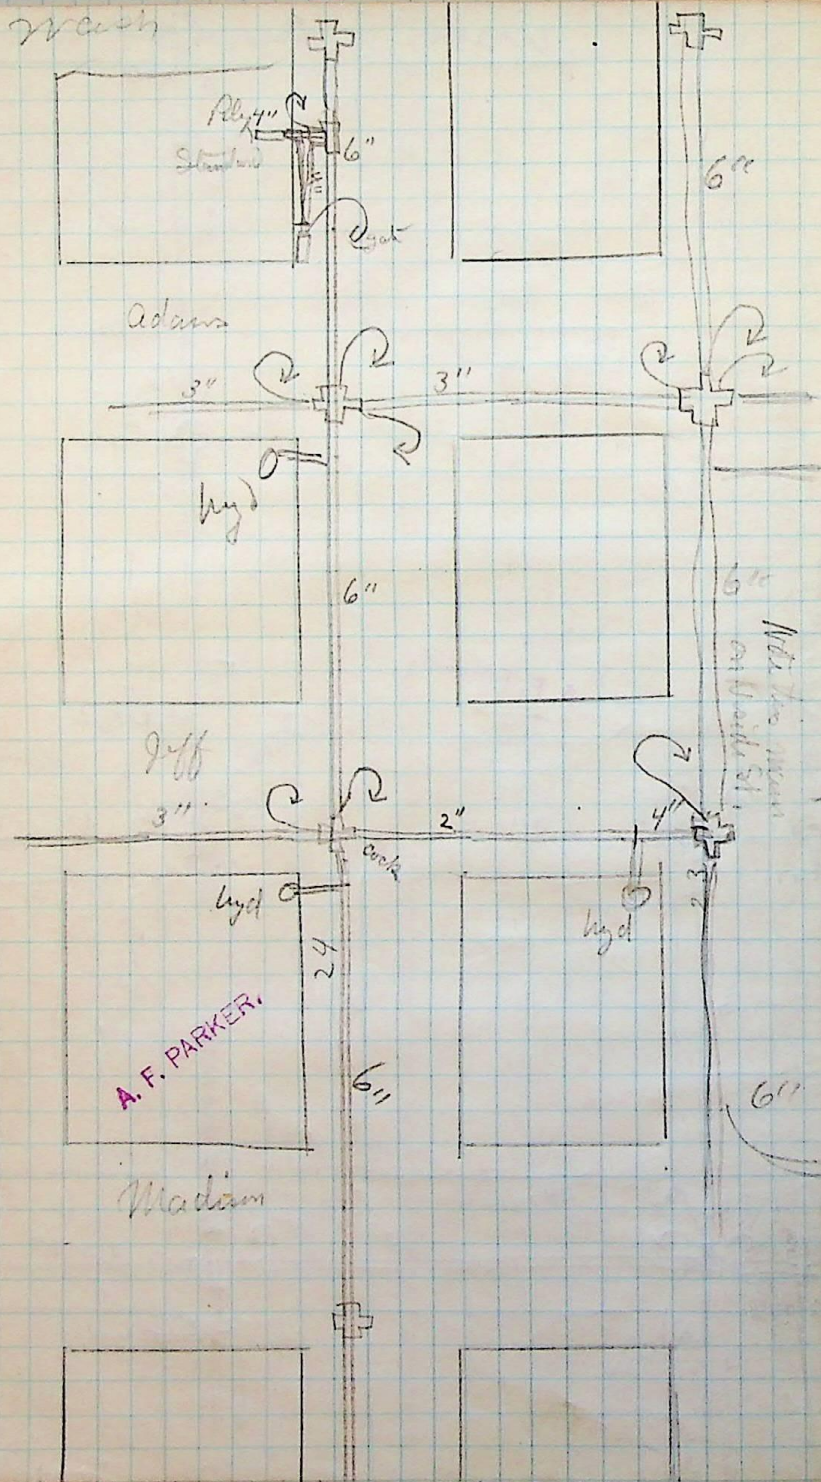