

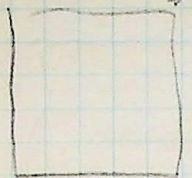



Jeff

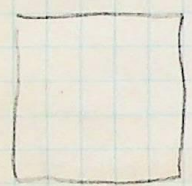



Mad

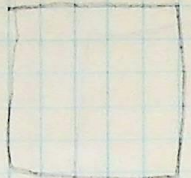

Mon

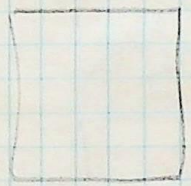


6"

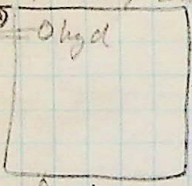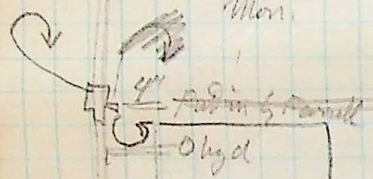

Olyd




22nd

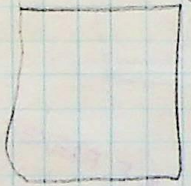



21st

20"


2mny

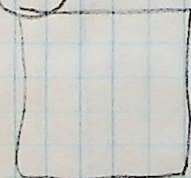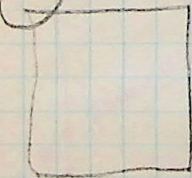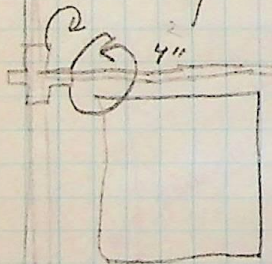




6"

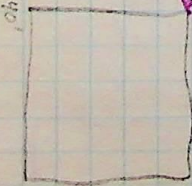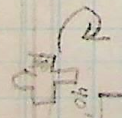





4

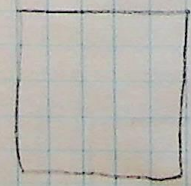

A. F. PARKER

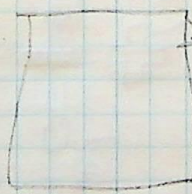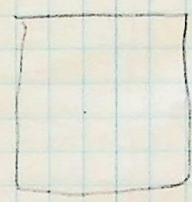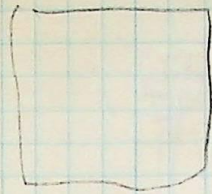

20

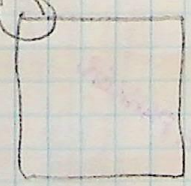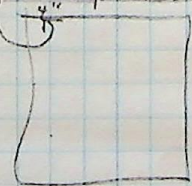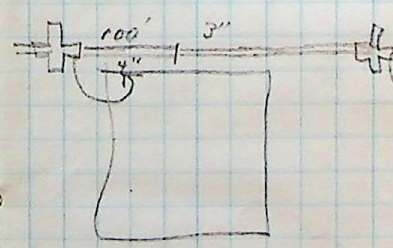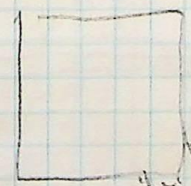

Private Pipe to Reform School

A. F. PARKER