



Waste

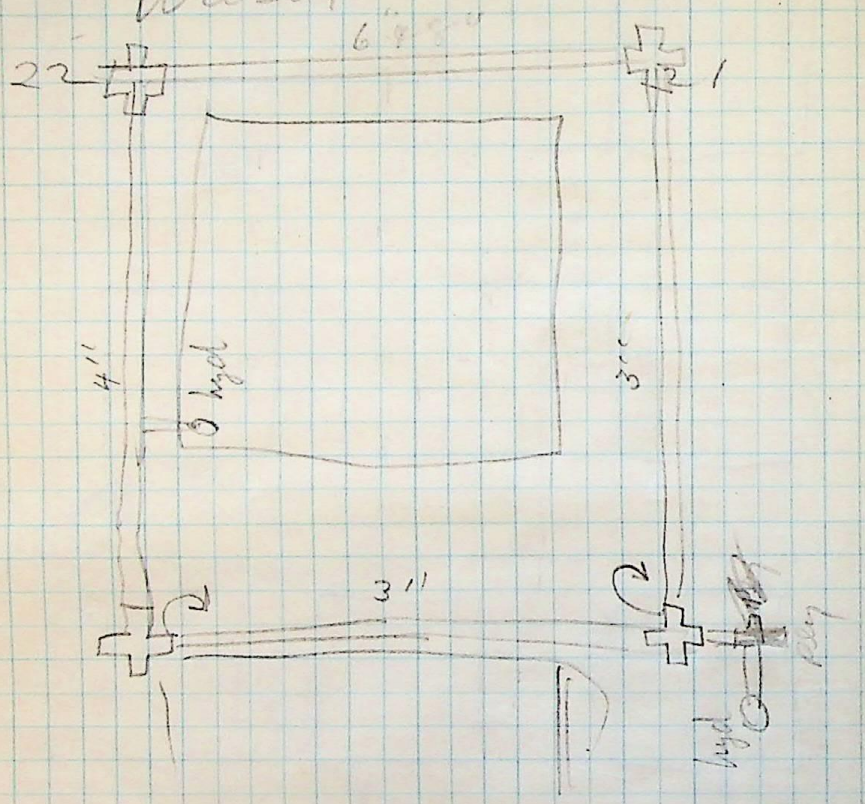

A. F. PARKER

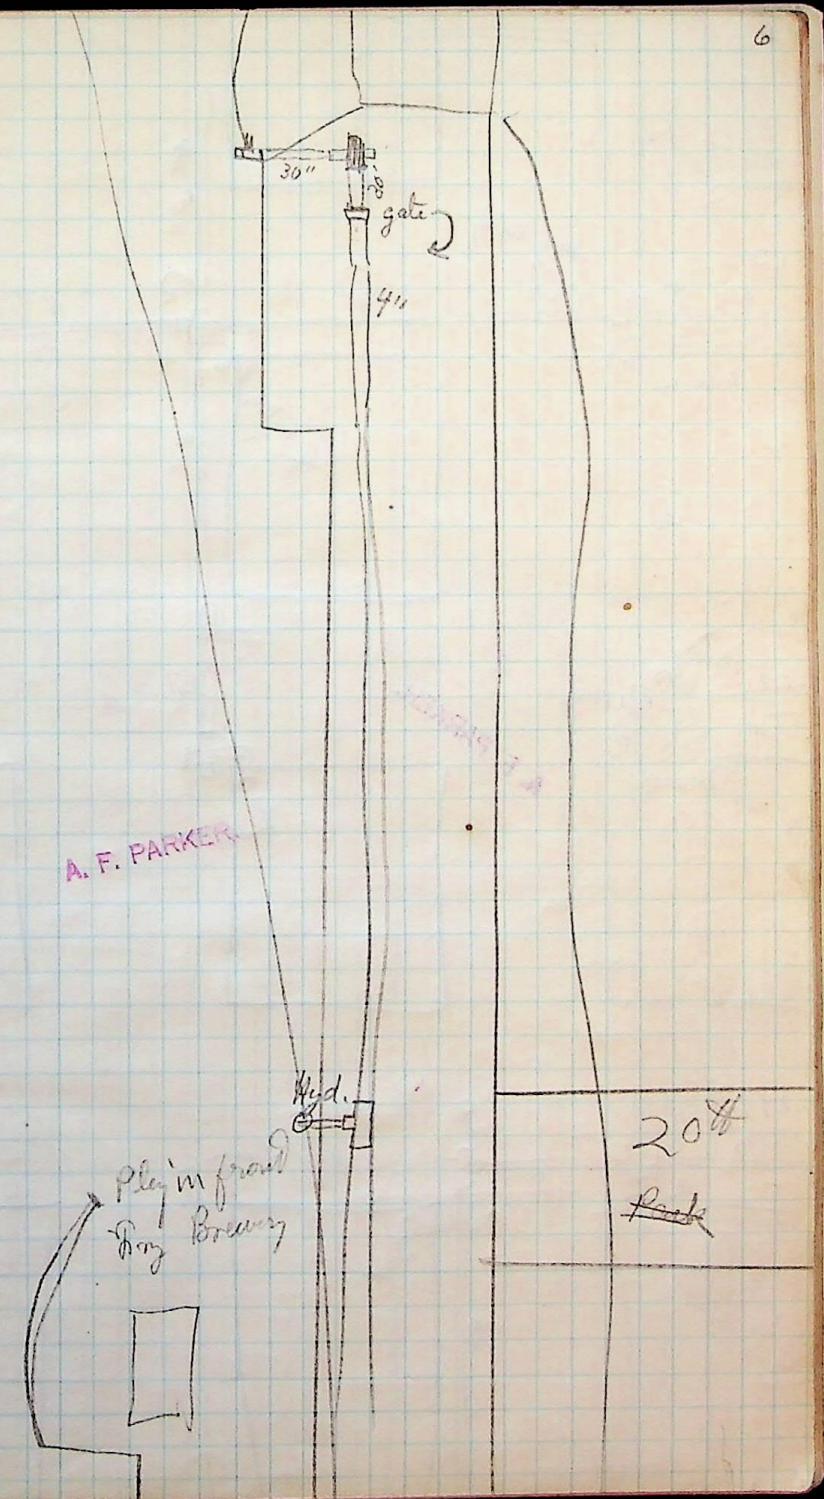

A. F. PARKER

20"
