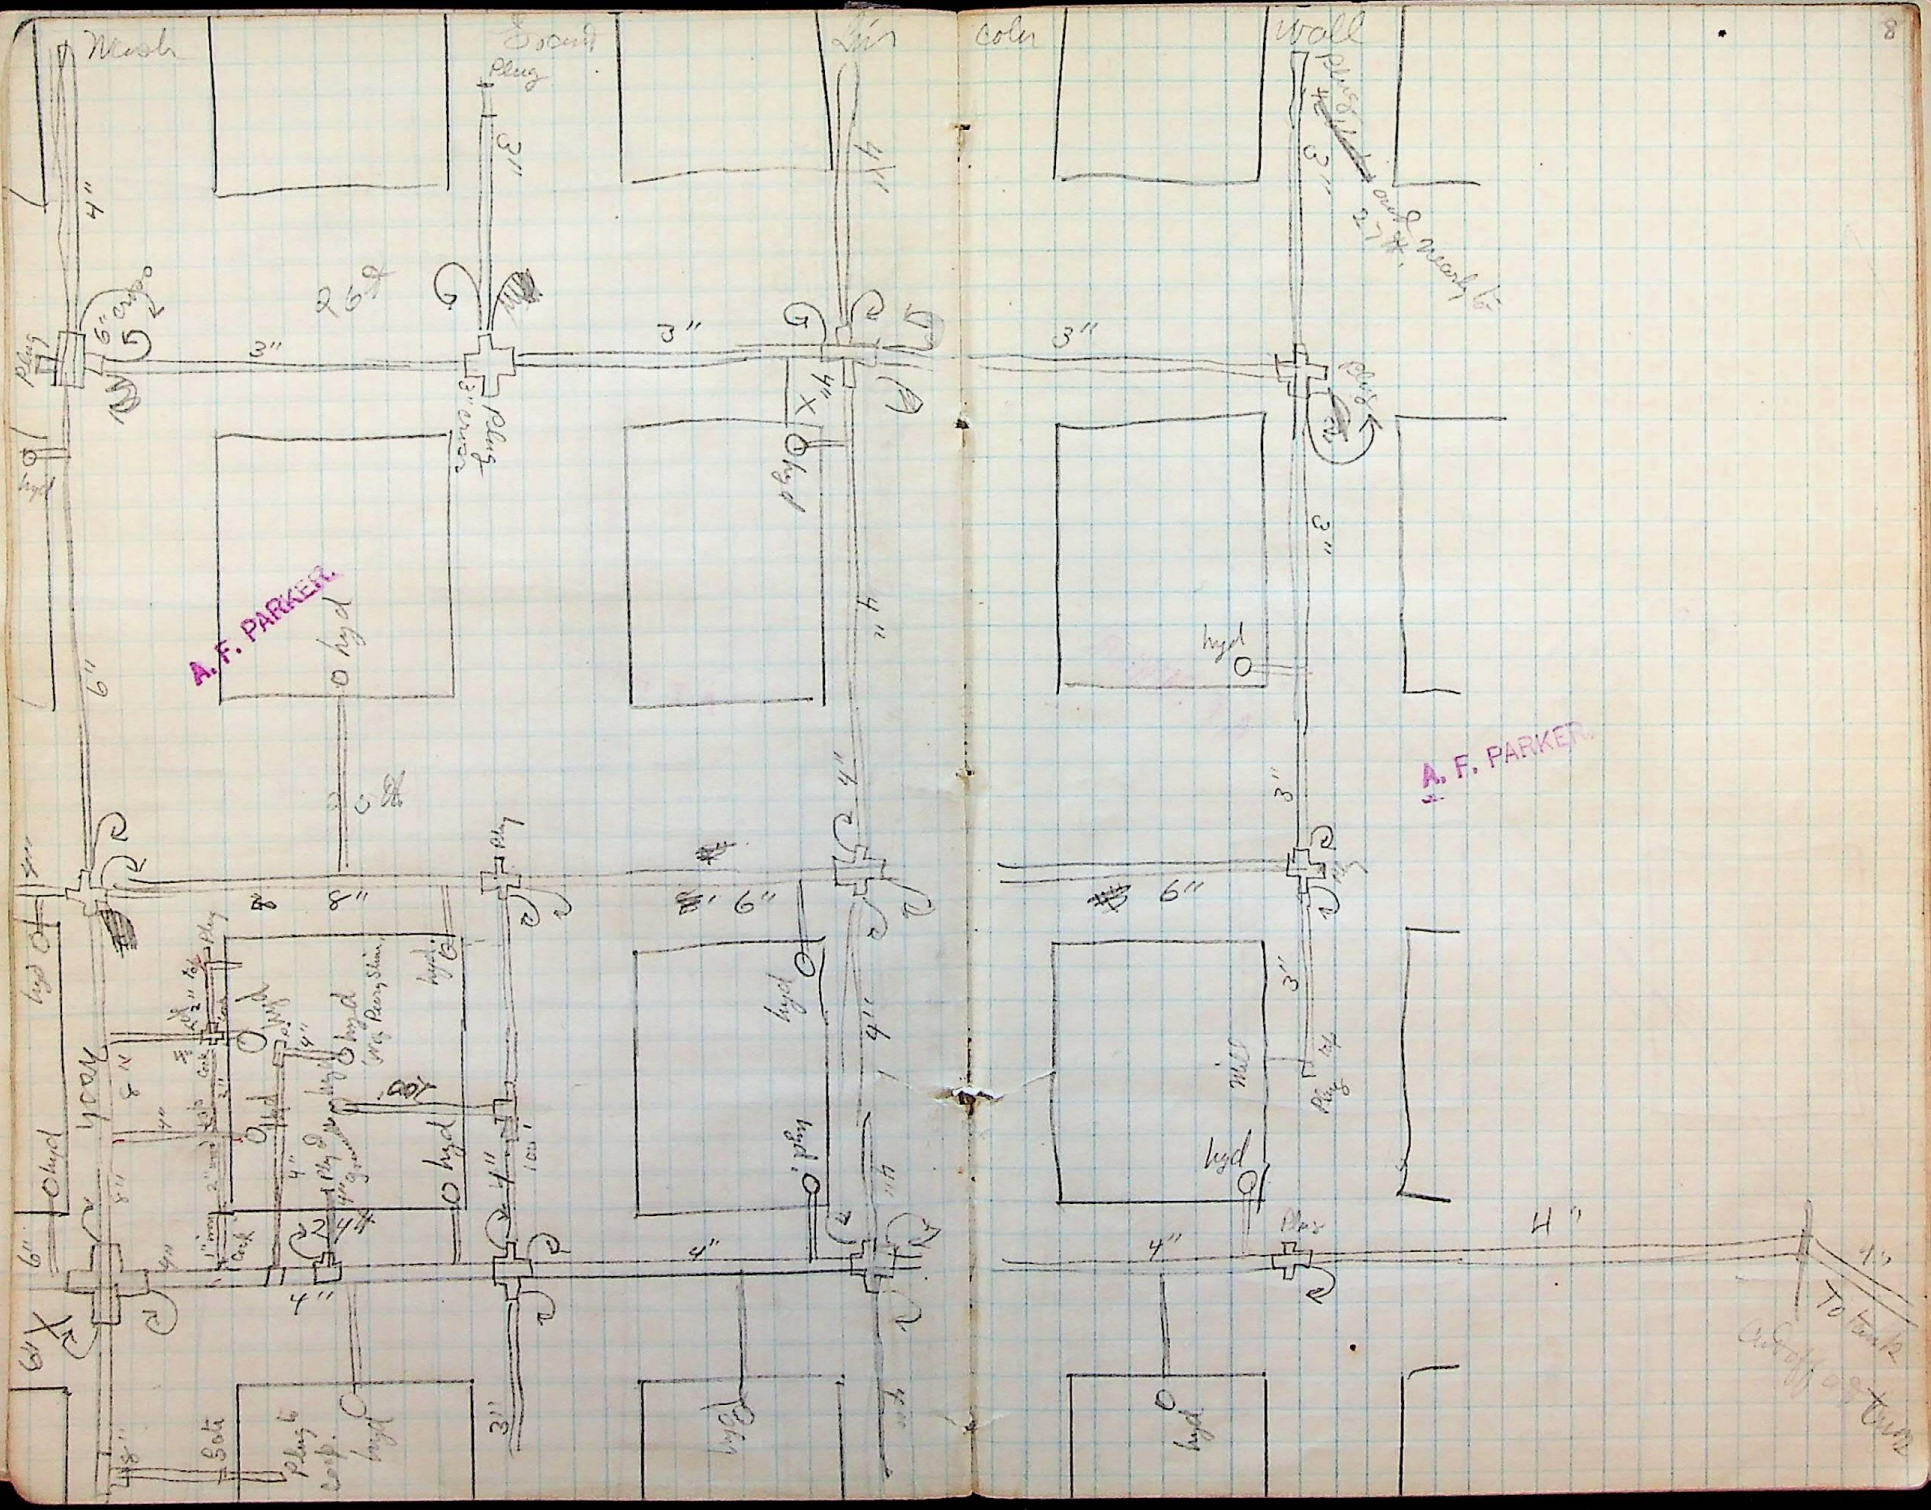
Mesh
Brown
Lin
Colin
Wall
A. F. PARKER
A. F. PARKER
hyd
Plug
3"
4"
6"
8"
To tank