


26



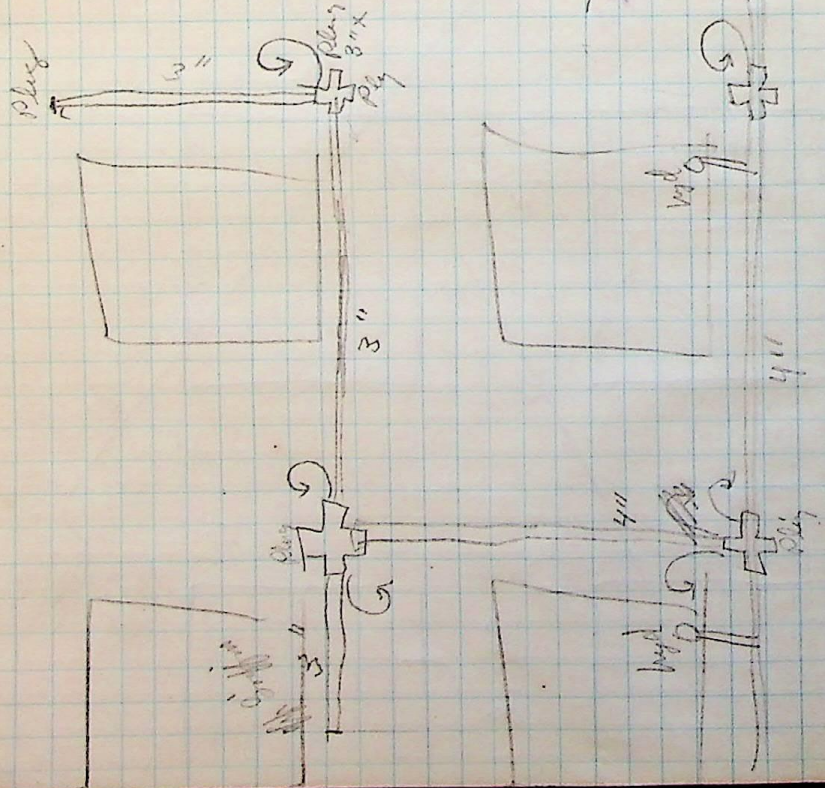










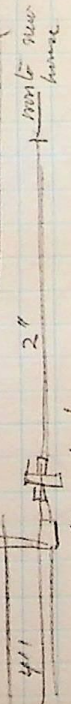

9" X

26

27