



A. F. PARKER

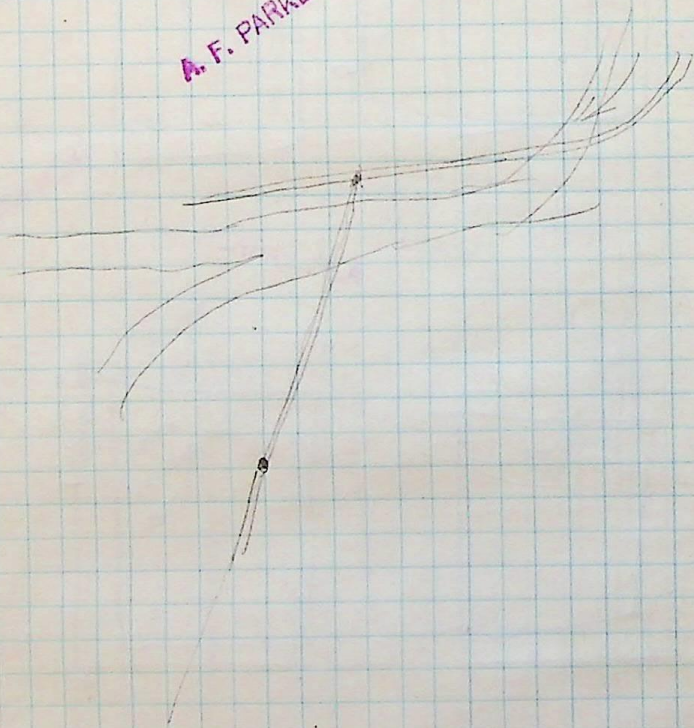

11
from Strong's. from Port
8" run about 40 rods - then
3 joints 6" then 40 rods 4"
with 4" gate at end. Then
6" about then 4, 6, & 8"
lengths to reservoir - as fluecy
sized em. To Gate where crosses
25th St. T plugged to East.

Waterfall - 3 joints 4" from
tank, then 3" to Strong's line.
gate half way.

A. F. PARKER

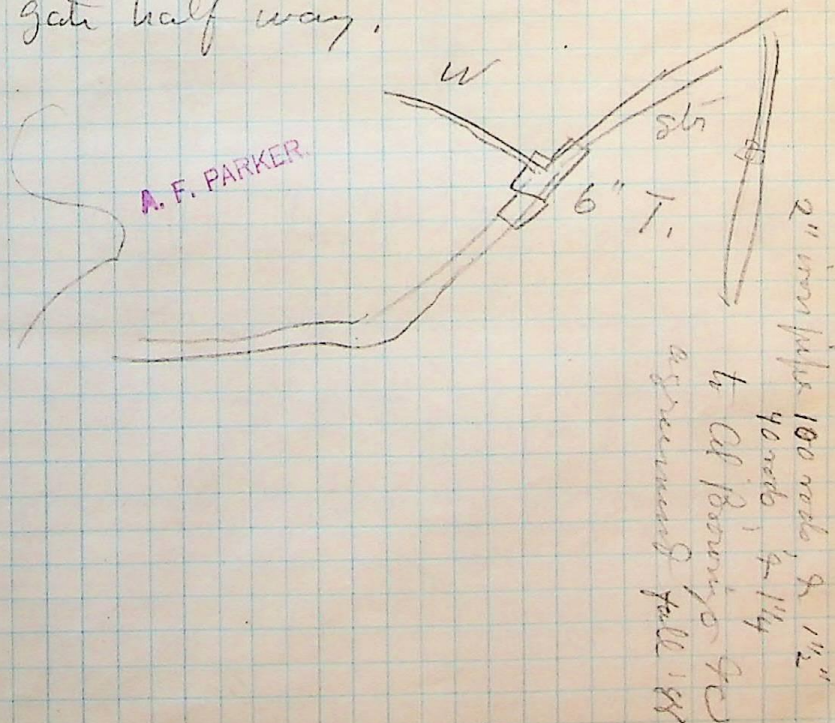

2" iron pipes 100 rods, & 1 1/2"
40 rods, 4 1/4"
to Old Brewery 90
agreement fall '88