


Aug. 28th 1889

Mouth of Sewer at
foot 24th St. W of Wall

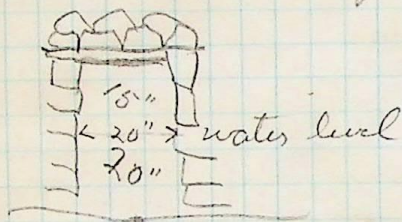

Appears to be meant to be 2"
wide & 3 ft. high.

About 6" deposit on bottom,
Vel. about foot per sec.

A. F. PARKER.

A. F. PARKER.

