
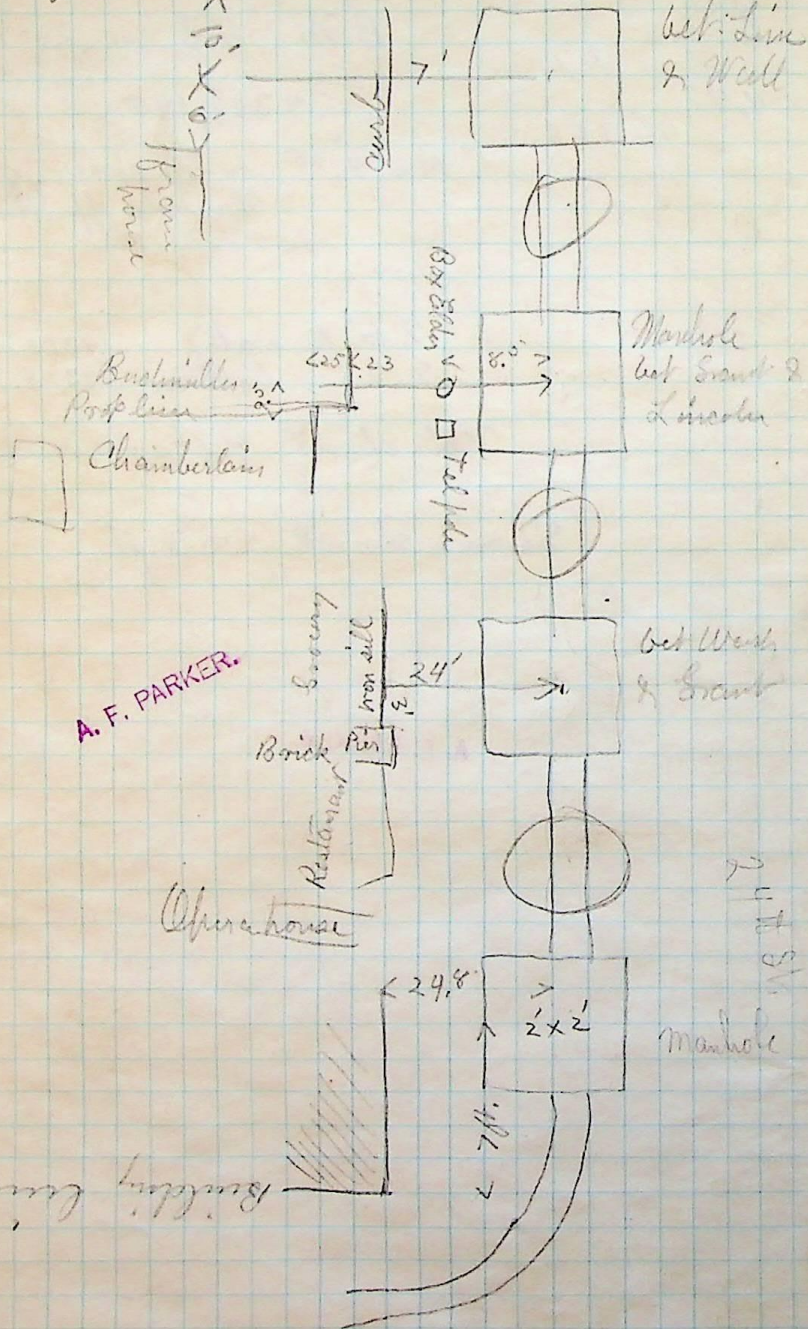


what from house

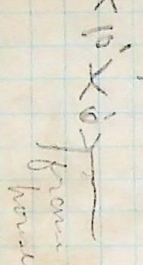


A. F. PARKER

Opera house

Wash Cistern

Off. pt. 10 ft w. of w. side reclos. chamber office

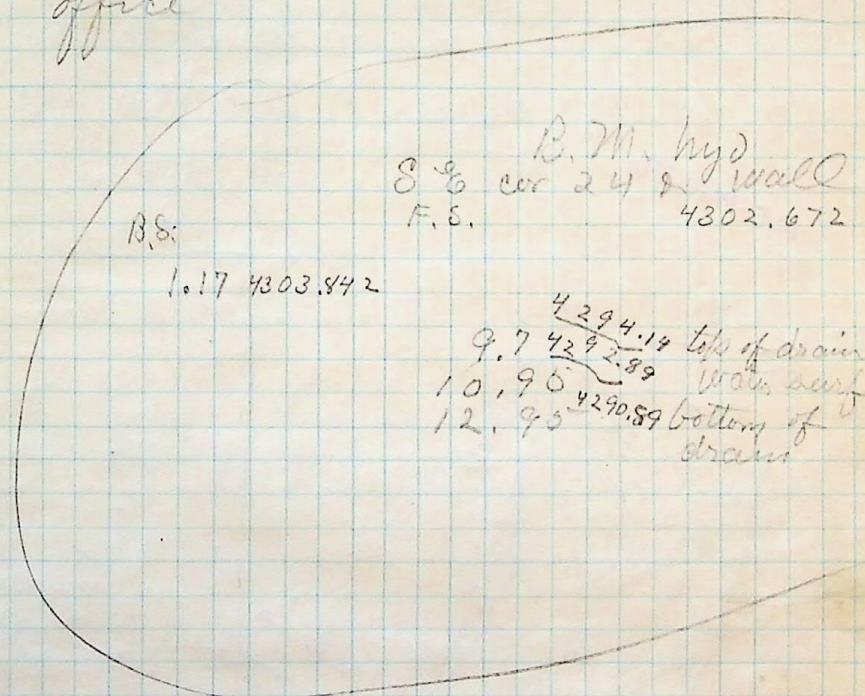

B.M. hyd wall
8.8 cor 24 & wall
F.S. 4302.672

B.S. 1.17 4303.842

4294.14 top of drain
 9.7 4292.89 wall surf
 10.95
 12.95 4290.89 bottom of drain

A. F. PARKER

B.M. Datum at Corp
4307.784

B.S. #1.
5.51 4313.294

6.88 4306.414 top manhole cover

4.41 4308.884 Brick pier top under Cor. Stone New Bg. NE cor Wash # 24

4297.91 water level 8.5' lower
4296.91 bottom 9.5' "

incl. 4 ft