

□ Mon No. 5

A. F. PARKER.

□ Mon No 4

□ Mon No. 3

26th St.

A. F. P.
766.1599

763.65

764.50



Dissected diff &
struck on old hub.


hub.
24th St.

□ Mon. No. 1

B. 26

Aug. 12 1889

Resetting cen. Wash. & 27th.
Self with
G. Shaw head
R " Back
Bingham flag
J. Shaw stake

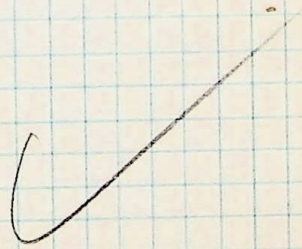

A. F. PARKER



B. 26