


Moffitts Lane Aug. 21st, 1889 <sup>3</sup>

A. F. PARKER.

A. F. PARKER.

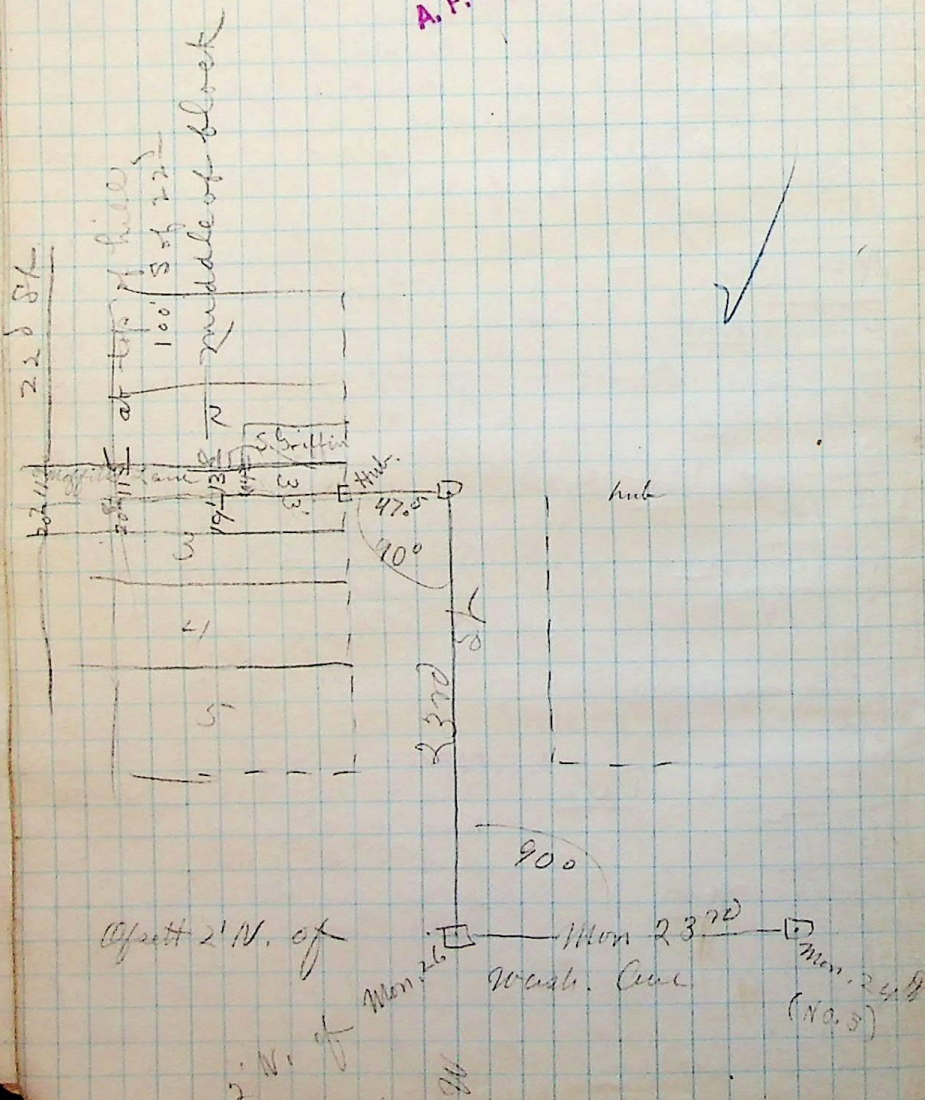

RECEIVED