

















A. F. PARKER.

B. 27

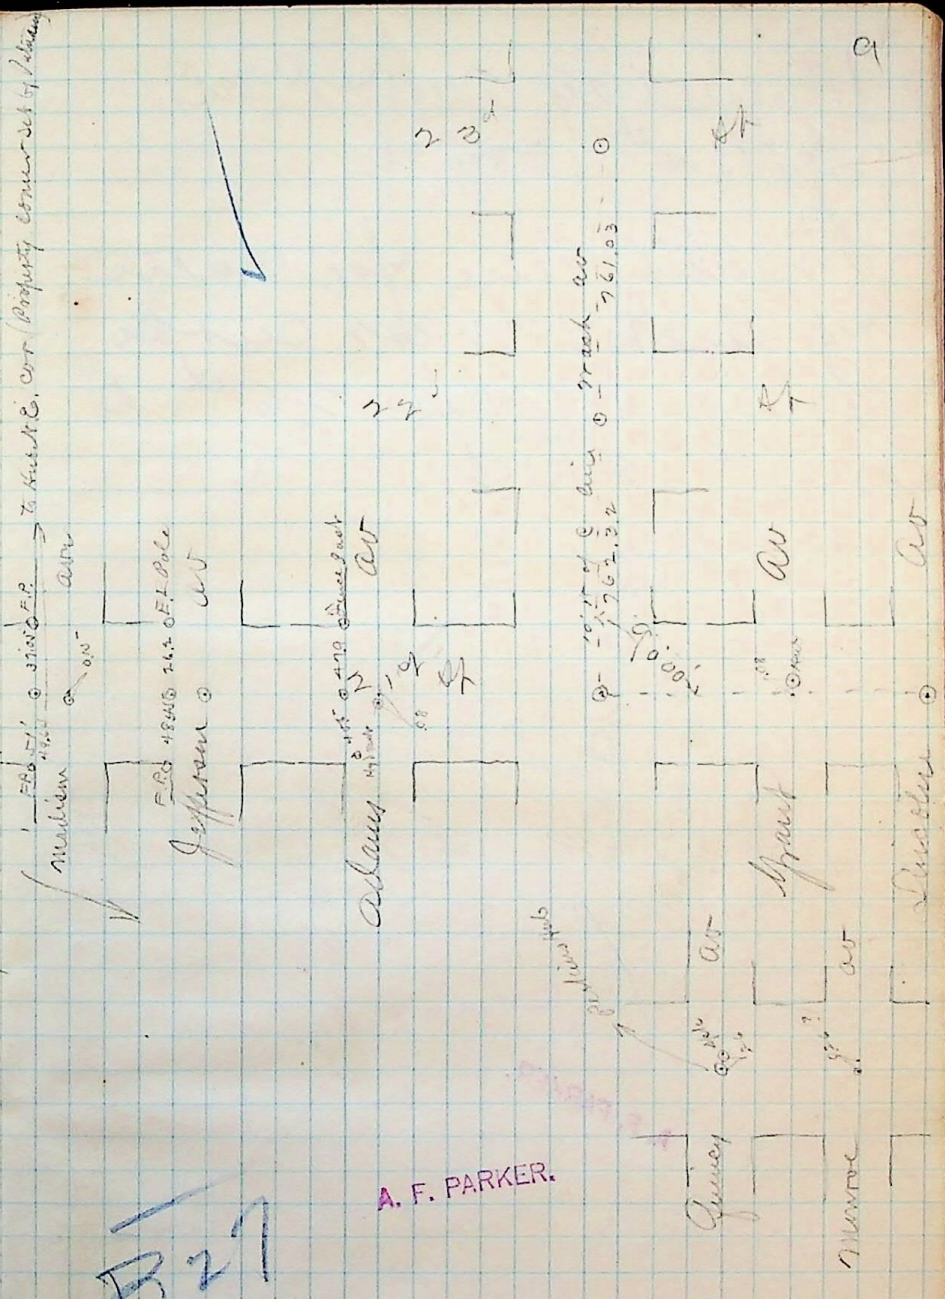

A. F. PARKER.

B. 27