

Mon No. 17

□ at 21 & Quincy →

and Check O.K.

Reverse

□

New hub 6' E of





B.S. on 21 & Lincoln & Reverse.

A. F. PARKER.

~~B27~~ ✓

A. F. PARKER.

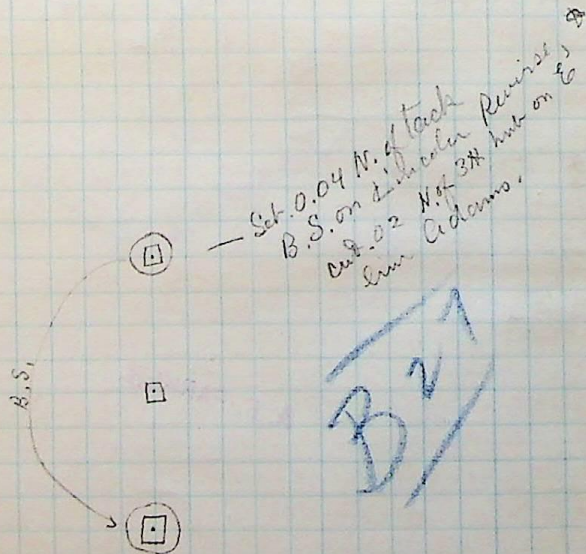

Hub at center Adams Ave  
- Appears a little S. of proper place

Mon No. 8 - 21st & Wash - F.S.

Hub at 21st & Lincoln - mark