

Mon No. 16



at 28 & Quincy


B.S. on 12



Reverse


On New Mon. No. 12

Mon No. 12

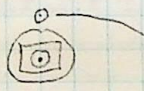

B.S. on No. 17

intersect hubs Quincy

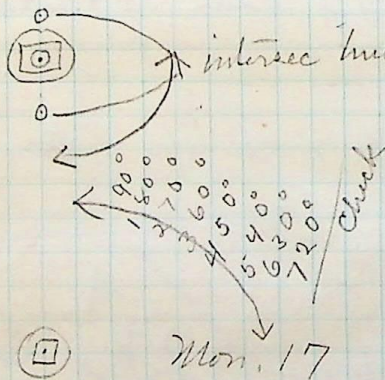

Mon. 17

A. F. PARKER.



does not check
Mon. 12 evidently
in error, being 1.52 W. of
line.

B21



Afternoon

Check ^{any} Angle N. Quincy to
W. 28th 90°
 180°
 270°
 360° ✓

hub between 26th & 27th check.

Reverse & double Center

On 24th, found Mon. Set 1.52 W. of line
Reset Mon. on 24th St. line & this line
See page 2 for this as corrected.

Angle from W. 24th to 21st & Quincy
appears to be $\frac{1}{4}$ minute too great.



B.S. E. line (6 ft. E of) Jeff & 21st.

A. F. PARKER.

Mon. No. 12 - (24th & Quincy)

B21

Mon No. 17 - 21st & Quincy.
B.S. on hub 6' E. of
line Jefferson

Not - Correll Pk Survey
by corners 1, 2, 3 (Each)
Cor. 26 & Quincy. (Long 48) by setting all