
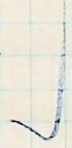


Mon. No. 16 - Cn. 28<sup>th</sup> & Quincy  
 Resub Sept. 6, 1889.

151

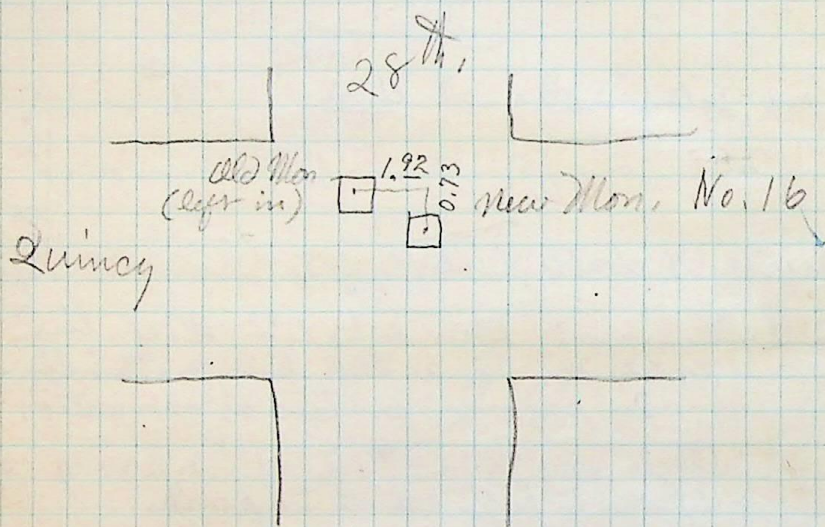

Pis To Mon No. 16

N.W.	71.48
N.E.	139.5
S.E.	45.30

B 28

- to fence cor post
- to S.W. cor brick building
- to St. sign post

A. F. PARKER.

A. F. PARKER.