

Saturday Am. Sept 7th 1889.


Establishing Centre
Wall across Quad 2 & 4th Street
preparatory to planting
Monument


A. F. PARKER.

2 4th Street

2 5th Street

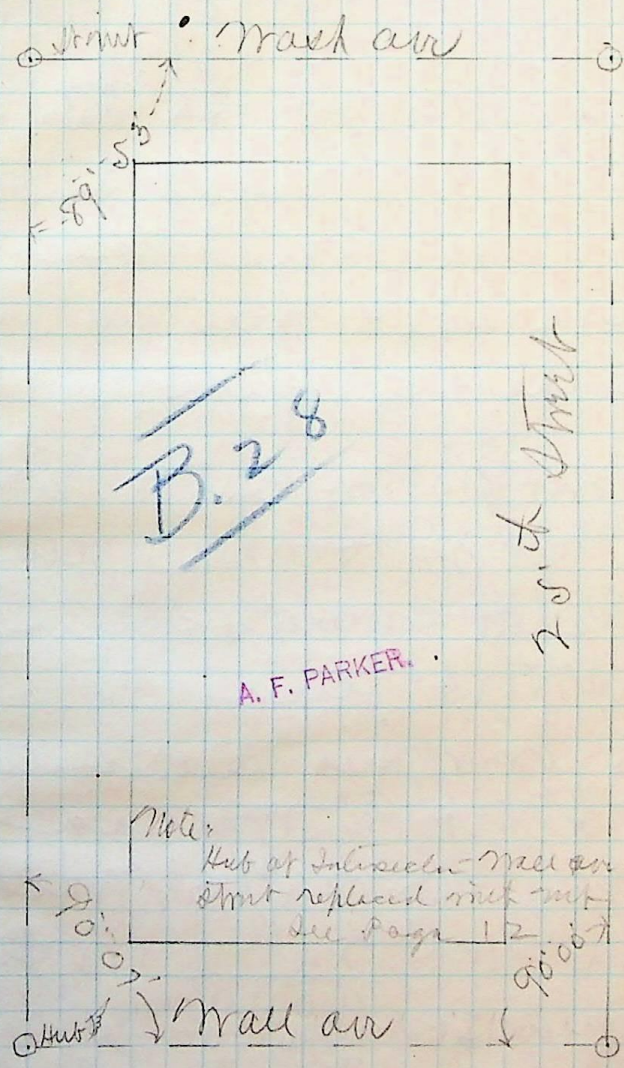

B. 28

A. F. PARKER.

Note:
Hub at intersection wall av + 2 4th
street replaced with
see page 12

Hub
Wall av

A. F. PARKER.