

Monday Aug Sept 9th, 1889

Survey for N.W. Cor of house
Viz:

Just over mt 21st + wash D.S. on
Hus Lincoln + 21st noted in Hus^o
on either side (strut line) Grant an
produced line to wall run on each
side same (strut line error)

Just over mt at 25th + wall
D.S. on mt 24th + wall line
produced to an intersection mt
21st street line


Into over Hus intersection
21st street and wall on
D.S. on mt 21st + wash^h and
D.S. on mt 25th + wall

Angles:

90° 00'
180° 00'
270° 00'
360° 00'
101) 1300.00
90.00

A. F. PARKER.

B28

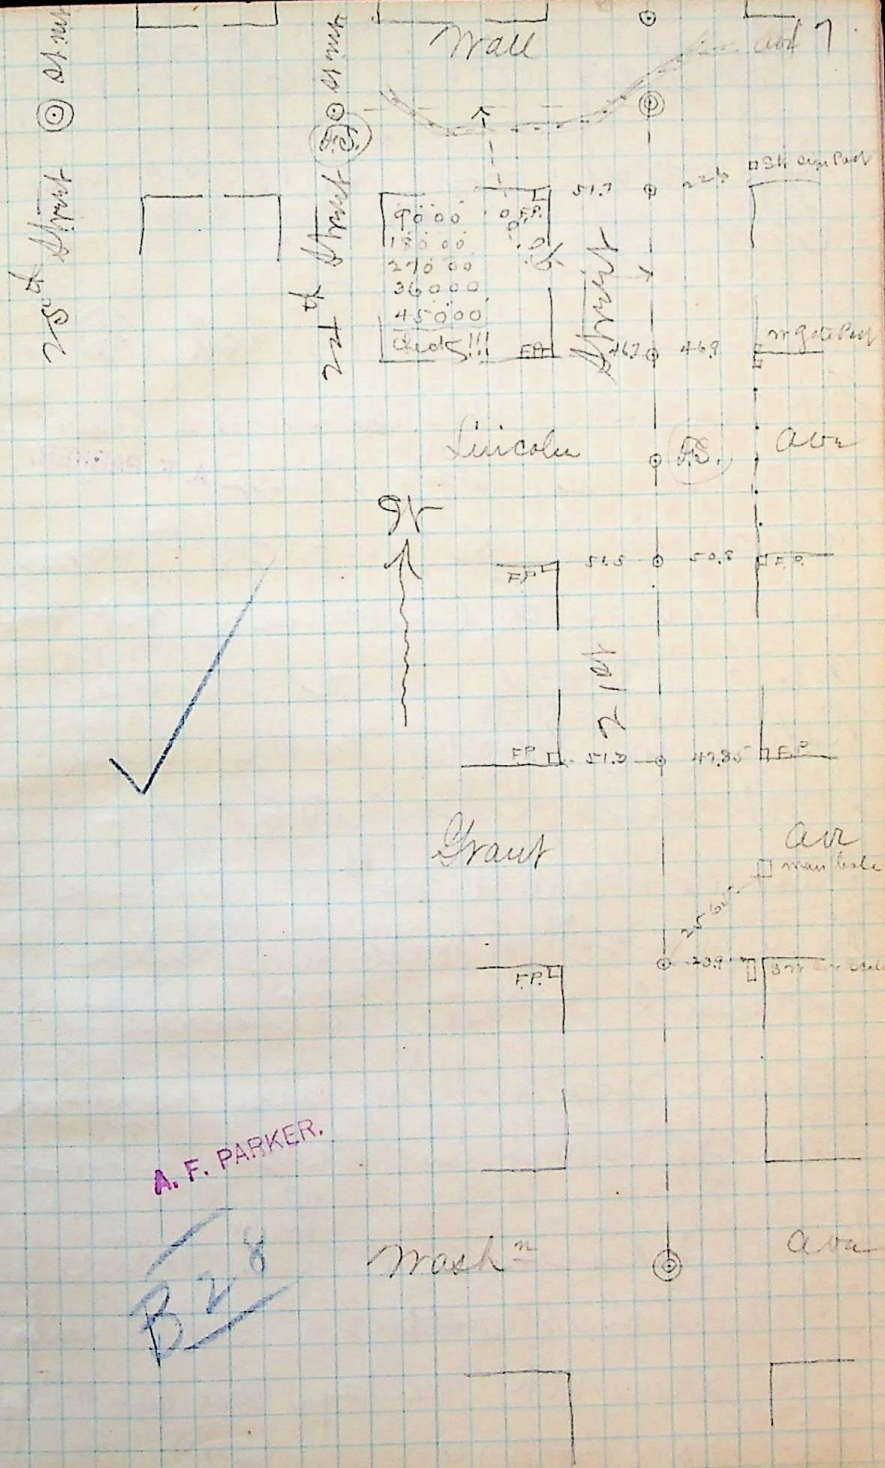

A. F. PARKER.

B28