

Tuesday Aug. Sept 10th 1889



Just over mt at 20th of wash
P.S. on mt 2 gth wash
checked 27th Street mt &
found the 26th st mt 0.15 East
(which had been eroded
over) set Hub on offset 2.0 S of line 26th & angle
Exp. Pole

Tuesday P.M. Sept 10th 1889

Intro Hub 2.0 S of mt at 26th of wash
P.S. on mt 20th of wash angle
to R + East to Hub on line Jefferson
am 9:00 (repeated this line
produced by double centers to
Quincy an intersection center
line same produced from mt
26th st & Hub on Quincy bet
26th & 27th Streets

A. F. PARKER

Note: After interesting mt
Centre line Quincy, angle did
mt check

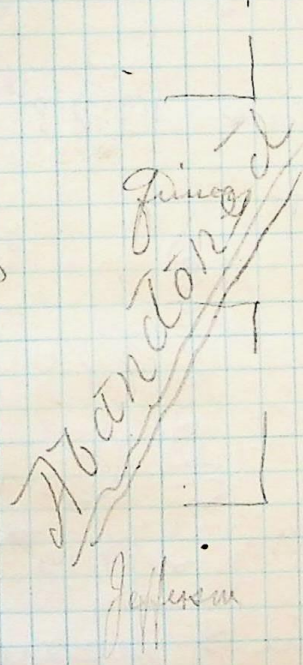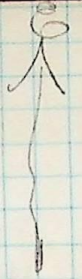

Wash

of a line 26th Street

2.0 offset south

A. F. PARKER

70