

No facing north

No 12


Dies;

- N. W. Balm Elder tree 48.00
- N. E. Street Sign Post 43.45
- S. E. Lower river Hydrant 47.50
- S. W. Box Elder tree 67.00

A. F. PARKER.

Thursday P.M. Sept 12<sup>th</sup> 1889

Resetting monument  
at Quincy Ave

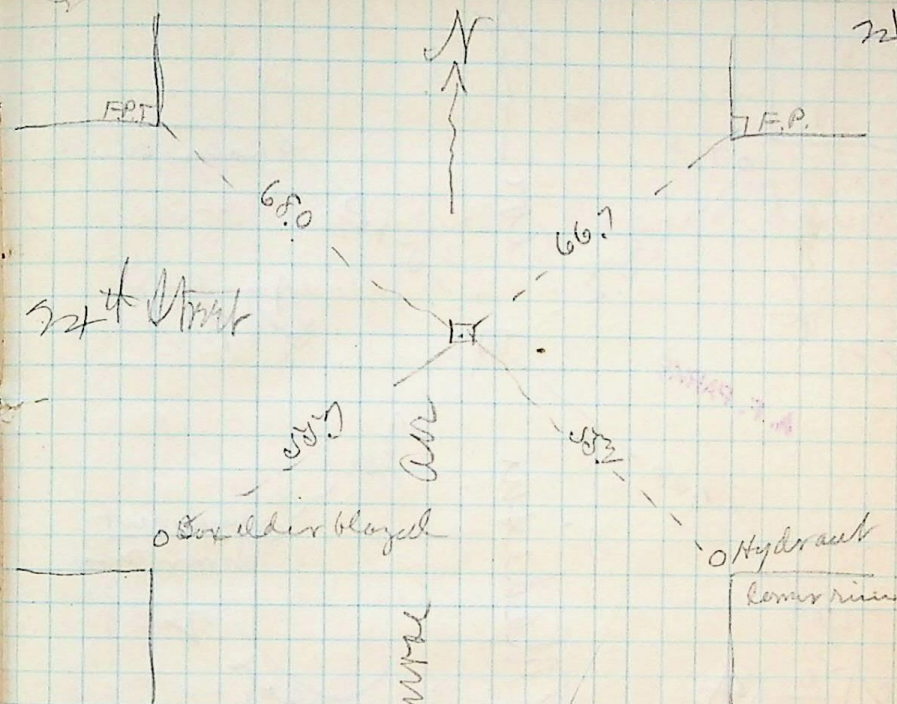

No facing north

No 15

Dies;

- N. W. to fence Post 68.0
- N. E. " " " 66.7
- S. E. lower river Hydrant 55.2
- S. W. Box elder blazed 55.7

A. F. PARKER

Thursday P.M. Sept 12<sup>th</sup> 1889  
Resetting monument  
at Monroe Ave