


Saturday Pm Sept 14th 1889
North curb line 23' at
from Grant to Washington Ave

(3A)

A. F. PARKER.

Washington Ave³⁰

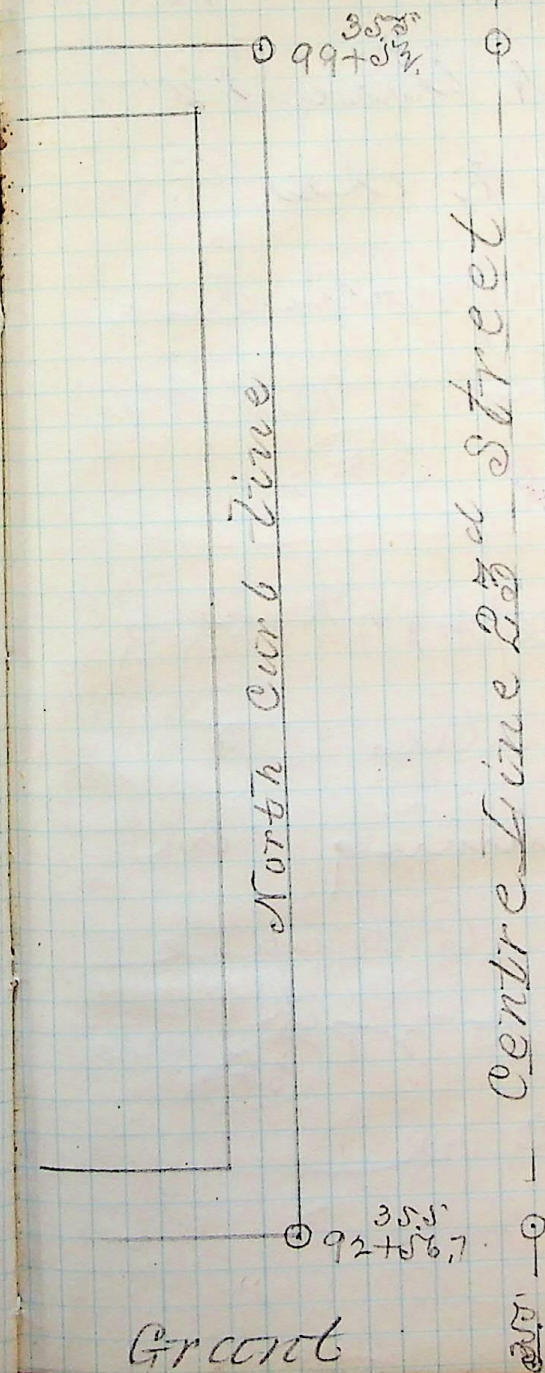

A. F. PARKER.

Grant

Ave