Wednesday Aug Sept 28th 1898

Stakes set for South curb of 28th Street between Grant and Washington Avenues in front of City Hall.

Stakes set 2.0 outside = (towards center of street) of curb line and every 50 feet.

See Field Book "Y" Page 41
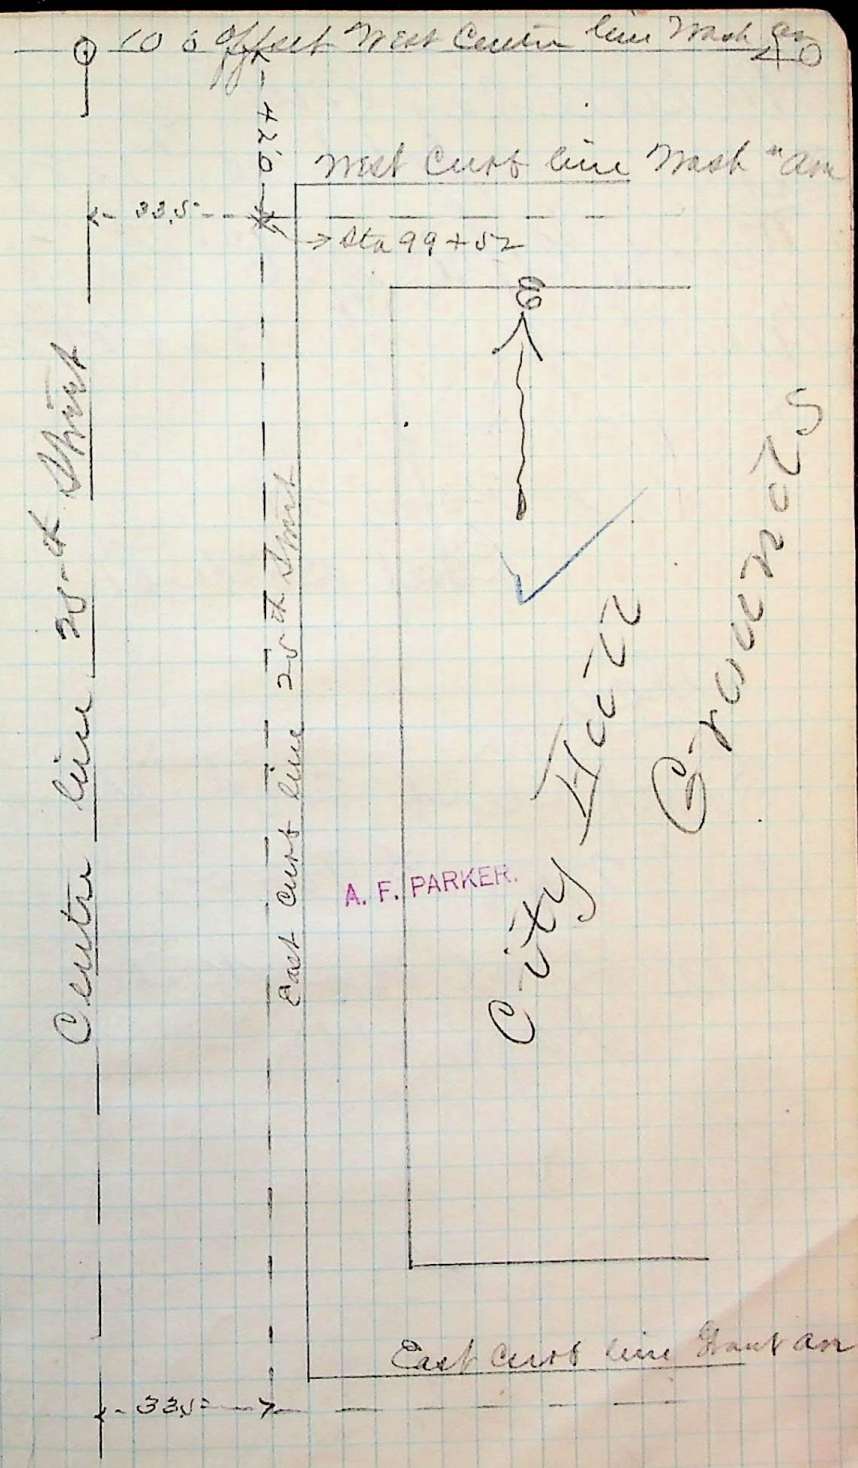
A. F. PARKER.