


Thursday Aug Sept 26th 1889

Centered Grade stakes set
for South Curb in front of
City Hall Wednesday am.
Sept 25th 1889

Thursday Aug. Sept 26th 1889

Planted Monument #25 Centre
Jackson Avenue 2nd 1/2th Street

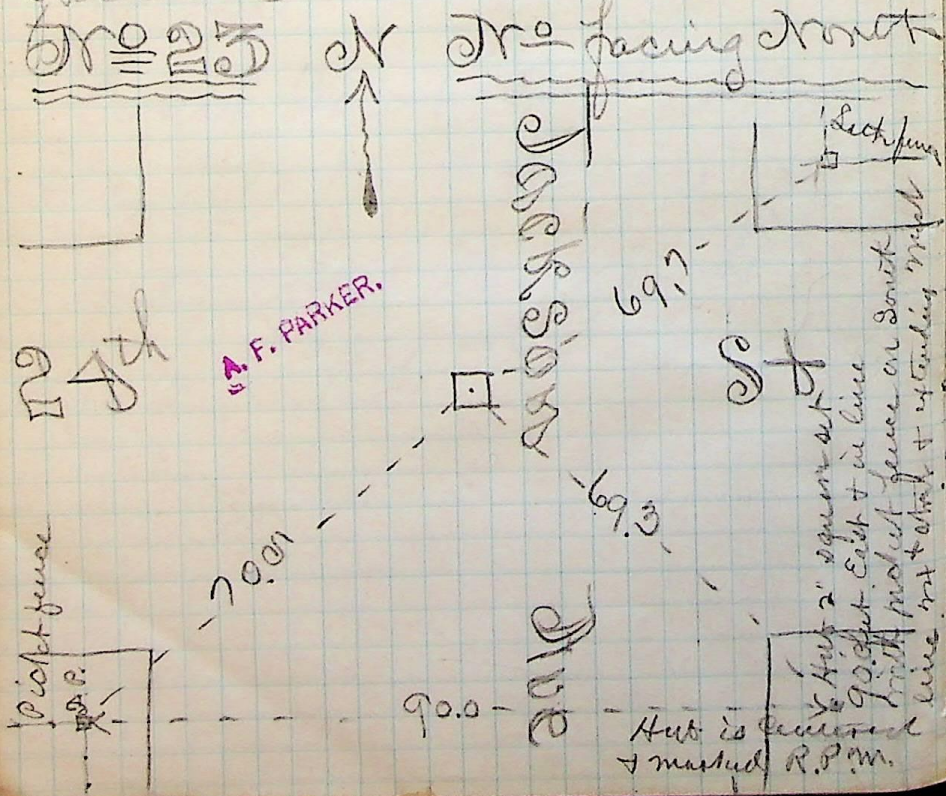

Thursday Aug. Sept 26th 1889

Planted Monument #24
Centre Harrison Avenue

